

MISSISSIPPI DEPARTMENT OF NATURAL RESOURCES

Bureau of Land and Water Resources

Southport Mall

P.O. Box 10631

Jackson, Mississippi 39209

WATER WELL DRILLERS LOG

TALLAHATCHIE
060
3/22/83

John Patton Chason

March 22 19 83
date well completed

John Patton Chason
Irrigation Equipment
firm name

Tallahatchie
county well located

LANDOWNER: T. C. Buford P. O. Box 210 Glendora, MS 38928 (mailing address)	description of formations encountered	from	to
	Clay	0	10'
	Fine Sand & Clay	10'	65'
	Coarse Sand	65'	75'
	Coarse Sand	75'	109'
	Large Rocks	107'	
CODED			
WELL LOCATION:			
sec. <u>19</u> T. <u>23</u> S. R. <u>1</u> E. <u>W</u>			
<u>5</u> miles North of <u>Glendora</u> (distance) (direction) (nearest town)			
WELL PURPOSE: irrigation (home, irrigation, municipal, industrial)			
WELL COMPLETION DATA:			
(1) diameter (inches) <u>16"</u>			
(2) total depth (feet) <u>109'</u>			
(3) static water level (feet) <u>20' below</u> top of ground. above			
(4) casing <u>steel</u> , <u>69'</u> (material) (depth) <u> </u> if telescope see back. (size)			
(5) screen <u>40'</u> , <u>69'-109'</u> (length) (depth to top) <u>16"</u> , <u>steel</u> (size) (material)			
(6) pump <u>80</u> <u>1400</u> (HP) (yield gpm) <u>diesel</u> (type power)			
(7) electric log <u>no</u> (yes or no) <u> </u> (organization running log)			
(8) how well bottom plugged <u>steel</u> <u>plate</u>			
DRILLERS REMARKS:			


DEPT. OF NATURAL RESOURCES
BUREAU OF LAND & WATER RESOURCES

APR - 4 1983

RECEIVED

If well telescopes please sketch and show depths.

GROUND LEVEL

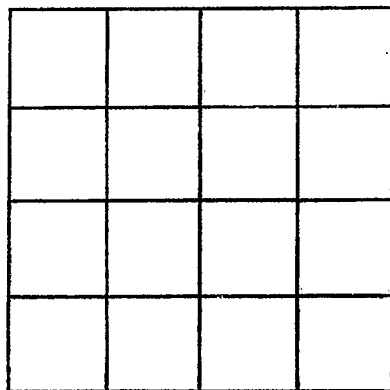

SECTION _____

Please indicate well location X.

ADDITIONAL INFORMATION

If more than one screen,
show locations of each on sketch.