

MISSISSIPPI DEPARTMENT OF NATURAL RESOURCES

Bureau of Land and Water Resources

Southport Mall

P.O. Box 10631

Jackson, Mississippi 39209

TALLAHATCHIE
 262
 3/17/83

WATER WELL DRILLERS LOG
 John Felton Chism

March 17 19 83 date well completed
 Irrigation Equipment. firm name
 Tallahatchie county well located

LANDOWNER:	description of formations encountered	from	to
T. C. Buford			
P. O. Box 210	Clay	0	15'
Glendora, MS 38928	Fine Sand	15'	35'
(mailing address)	Coarse Sand	35'	65'
WELL LOCATION:	Fine Sand	65'	85'
sec. 19 T. 23 N. R. 1 E	Coarse Sand & Gravel	85'	108'
8 miles West of Glendora	Clay	108'	
(distance) (direction) (nearest town)			
WELL PURPOSE: irrigation			
(home, irrigation, municipal, industrial)			
WELL COMPLETION DATA:			
(1) diameter (inches) 16"			
(2) total depth (feet) 108'			
(3) static water level (feet) 23' ^{below} top of ground.			
(4) casing steel, 0-40', 60-88'			
(material) (depth)			
(size) if telescope see back.			
(5) screen 40', 40'-60', 88'-108'			
(length) (depth to top)			
16" steel			
(size) (material)			
(6) pump no (HP) no (yield gpm)			
-0- (type power)			
(7) electric log NO (yes or no)			
(organization running log)			
(8) how well bottom plugged steel plate			
DRILLERS REMARKS:			

CODED


DEPT. OF NATURAL RESOURCES
 BUREAU OF LAND & WATER RESOURCES

APR - 4 1983

RECEIVED

If well telescopes please
sketch and show depths.

GROUND LEVEL

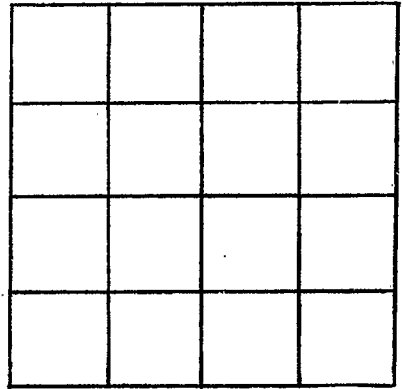

SECTION _____

Please indicate well location X.

ADDITIONAL INFORMATION

If more than one screen,
show locations of each on sketch.