

MISSISSIPPI DEPARTMENT OF NATURAL RESOURCES

Bureau of Land and Water Resources

Southport Mall

P.O. Box 10631

Jackson, Mississippi 39209

WATER WELL DRILLERS LOG

John Patton Olsen

Irrigation Equipment

Tallahatchie

TALLAHATCHIE
063
3/15/83

6

March 15 19 83
date well completed

firm name

county well located

LANDOWNER: T. C. Buford
P. O. Box 210
Glendora, MS 28928
(mailing address)

description of formations encountered	from	to
Fine Sand	0'	38'
Coarse Sand	38'	60'
Sand & Clay	60'	70'
Coarse Sand & Gravel	70'	105'
Clay	105'	

WELL LOCATION:
sec. 19 T 23 (N) R 1 E
S (W)
8 miles West of Glendora
(distance) (direction) (nearest town)

WELL PURPOSE: irrigation
(home, irrigation, municipal, industrial)

- WELL COMPLETION DATA:
- (1) diameter (inches) 16"
 - (2) total depth (feet) 105'
 - (3) static water level (feet) 22 ^{below} ~~above~~ top of ground.
 - (4) casing steel, 0-65',
(material) (depth)
(size) if telescope see back.
 - (5) screen 40', 65'-105'
(length) (depth to top)
16" Steel
(size) (material)
 - (6) pump 60 1000
(HP) (yield gpm)
diesel
(type power)
 - (7) electric log (yes or no)
(organization running log)
 - (8) how well bottom plugged Steel
plate

CODED

DEPT. OF NATURAL RESOURCES
BUREAU OF LAND & WATER RESOURCES


APR 4 1983

RECEIVED

DRILLERS REMARKS:

If well telescopes please
sketch and show depths.

GROUND LEVEL

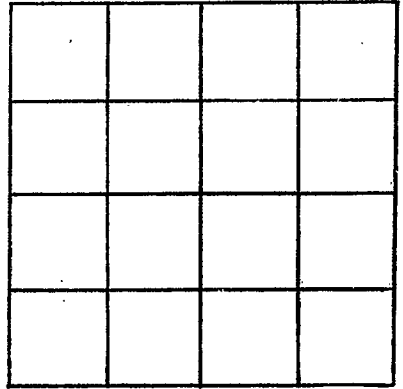

SECTION _____

Please indicate well location X.

ADDITIONAL INFORMATION

If more than one screen,
show locations of each on sketch.