

MISSISSIPPI DEPARTMENT OF NATURAL RESOURCES

Bureau of Land and Water Resources

Southport Mall

108 D (B)

P.O. Box 10631

Jackson, Mississippi 39209

135

WATER WELL DRILLERS LOG

BUTANE GAS COMPANY

OF GREENWOOD

Tallahatchie

065 Tallahatchie
LEFLORE
8-19-83

8-19 1983
date well completed

firm name

county well located

LANDOWNER:	description of formations encountered	from	to
DAN Reynolds	Clay	0	20
Glendora, Mo. (mailing address)	sand & gravel	20	103
WELL LOCATION:			
sec. 25 T-28N R-1E 2 1/2 miles E of Glendora (distance) (direction) (nearest town)			
WELL PURPOSE: (home, irrigation, municipal, industrial)			
WELL COMPLETION DATA:			
(1) diameter (inches) 6"			
(2) total depth (feet) 103			
(3) static water level (feet) 18 below top of ground.			
(4) casing steel 63' (material) (depth) 6" (size) if telescope see back.			
(5) screen 40' 63' (length) (depth to top)			
6" Steel (size) (material)			
(6) pump 40 1000 (HP) (yield gpm)			
Propane (type power)			
(7) electric log No (yes or no)			
No (organization running log)			
(8) how well bottom plugged: Steel plate			
DRILLERS REMARKS: Carlos Ramos			


DEPT. OF NATURAL RESOURCES
BUREAU OF LAND & WATER RESOURCES

SEP 15 1983

RECEIVED

If well telescopes please sketch and show depths.

GROUND LEVEL

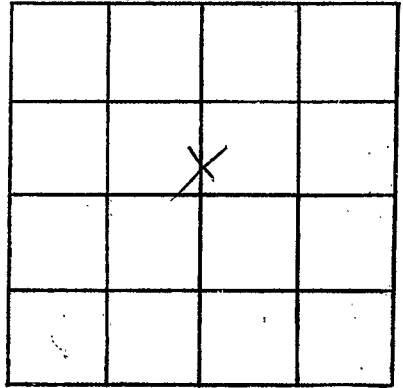

SECTION 25

Please indicate well location X.

ADDITIONAL INFORMATION

If more than one screen, show locations of each on sketch.