

MISSISSIPPI DEPARTMENT OF NATURAL RESOURCES

Bureau of Land and Water Resources

Southport Mall

P.O. Box 10631

Jackson, Mississippi 39209

BUTANE GAS WATER WELL DRILLERS LOG

POST OFFICE BOX 1135

1980 GREENWOOD, MISS. 39930

county well located

CODED

Tallahatchie

066
TALLAHATCHIE
10-28-83

10-28 date well completed

firm name

LANDOWNER:

Ralph Hand

Glendora Mo.
(mailing address)

description of formations encountered

CLAY

SAND + GRAVEL

from

to

1 70
70 108

WELL LOCATION:

sec. 35 T. 23 N. R. 1 E. S. 5
2 miles S.E. of Glendora
(distance) (direction) (nearest town)

WELL PURPOSE: Irrigation
(home, irrigation, municipal, industrial)

WELL COMPLETION DATA:

- (1) diameter (inches) 16"
- (2) total depth (feet) 108
- (3) static water level (feet) 6 below top of ground.
- (4) casing steel 68 (material), (depth)
16" (size) if telescope see back.
- (5) screen 40 68 (length), (depth to top)
16" steel (size), (material)
- (6) pump 150 1800 (HP), (yield gpm)
Diesel (type power)
- (7) electric log No (yes or no)
No (organization running log)

(8) how well bottom plugged
steel plate

DRILLERS REMARKS:

Carlos RAMOS


DEPT. OF NATURAL RESOURCES
BUREAU OF LAND & WATER RESOURCES

NOV 14 1983

RECEIVED

If well telescopes please sketch and show depths.

GROUND LEVEL

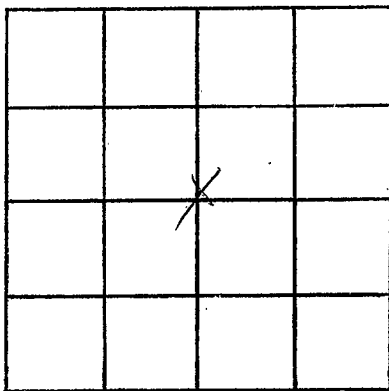

SECTION 35

Please indicate well location X.

ADDITIONAL INFORMATION

If more than one screen,
show locations of each on sketch.