

MISSISSIPPI DEPARTMENT OF NATURAL RESOURCES

Bureau of Land and Water Resources

Southport Mall

P.O. Box 10631

Jackson, Mississippi 39209

WATER WELL DRILLERS LOG

CODED

TALLAHATCHIE
 Q 68
 11/22/83

Nov-22, 1983 date well completed
 Dyer Well & Irrigation firm name
 Tallahatchie county well located

LANDOWNER: <u>Matt Dale</u>	description of formations encountered	from	to
Glendora Miss. (mailing address)	Clay Sand & Gravel	D 86	86 120
WELL LOCATION: sec. <u>11 T 32 N</u> R. <u>1 E</u> <u>23 S</u> <u>5</u> miles <u>N</u> of <u>Glendora</u> (distance) (direction) (nearest town)			
WELL PURPOSE: <u>IRrigation</u> (home, irrigation, municipal, industrial)			
WELL COMPLETION DATA:			
(1) diameter (inches) <u>16"</u>			
(2) total depth (feet) <u>120'</u>			
(3) static water level (feet) <u>24'</u> below above top of ground.			
(4) casing <u>Steel</u> (material) (depth)			
<u>16"</u> (size) if telescope see back.			
(5) screen <u>36'</u> <u>84'</u> <u>86'</u> (length) (depth to top)			
<u>16"</u> (size) <u>Mild Steel</u> (material)			
(6) pump <u>130</u> <u>2,500</u> (HP) (yield gpm)			
<u>Diesel</u> (type power)			
(7) electric log <u>No</u> (yes or no)			
(organization running log)			
(8) how well bottom plugged <u>Plate</u>			

CODED

DEPT. OF NATURAL RESOURCES
 BUREAU OF LAND & WATER RESOURCES


DEC -7 1983

RECEIVED

DRILLERS REMARKS:

If well telescopes please
sketch and show depths.

GROUND LEVEL

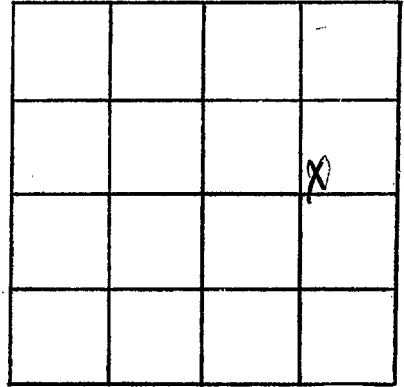

SECTION 12

Please indicate well location X.

ADDITIONAL INFORMATION

If more than one screen,
show locations of each on sketch.