

MISSISSIPPI DEPARTMENT OF NATURAL RESOURCES

Bureau of Land and Water Resources

Southport Mall

P.O. Box 10631

Jackson, Mississippi 39209

WATER WELL DRILLERS LOG

CODED

TALLAHATCHIE  
 Q 69  
 11/23/83

Nov. 23, 1983 date well completed  
 Dyer Well + Irrigation firm name  
 Tallahatchie county well located

LANDOWNER: Matt Dale  
Glendora, Miss.  
 (mailing address)

description of formations encountered	from	to
Clay	0	38
Hard Sand	38	58
Sand + gravel	58	100

WELL LOCATION:  
 sec. 12 T 32 N R 1 E  
23 S  
5 miles N of Glendora  
 (distance) (direction) (nearest town)

WELL PURPOSE: irrigation  
 (home, irrigation, municipal, industrial)

WELL COMPLETION DATA:

(1) diameter (inches) 16"

(2) total depth (feet) 110'

(3) static water level (feet) 24' below above top of ground.

(4) casing Steel, 70'  
 (material) (depth)  
16" if telescope see back.  
 (size)

(5) screen 40', 70'  
 (length) (depth to top)  
16", Mild Steel  
 (size) (material)

(6) pump 100, 2,000  
 (HP) (yield gpm)  
Diesel  
 (type power)

(7) electric log No  
 (yes or no)

(organization running log)

(8) how well bottom plugged Plate

CODED

DEPT. OF NATURAL RESOURCES  
 BUREAU OF LAND & WATER RESOURCES


DEC - 7 1983

RECEIVED

DRILLERS REMARKS:

If well telescopes please sketch and show depths.

GROUND LEVEL

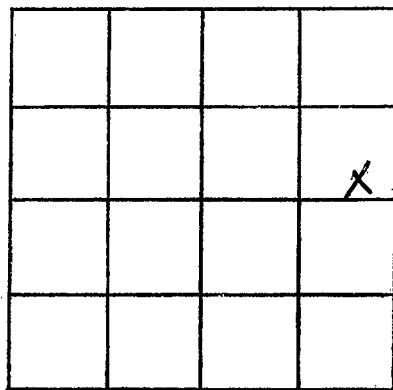

SECTION 11

Please indicate well location X.

ADDITIONAL INFORMATION

If more than one screen,  
show locations of each on sketch.