

MISSISSIPPI DEPARTMENT OF NATURAL RESOURCES

Bureau of Land and Water Resources

Southport Mall

P.O. Box 10631

Jackson, Mississippi 39209

WATER WELL DRILLERS LOG

CODE 1

Φ 70
TALLAHATCHIE
3-15-84

March 15, 1984 Dyer Well + Irrigation Tallahatchie
date well completed firm name county well located

LANDOWNER: <u>W. L. Lowe</u>	description of formations encountered	from	to
<u>Glendora, Miss. 38928</u> (mailing address)	<u>Clay</u>	<u>0</u>	<u>21</u>
WELL LOCATION: sec. <u>24</u> T. <u>23</u> S. R. <u>1</u> E. <u>W</u>	<u>Thin Sand</u>	<u>21</u>	<u>48</u>
<u>1 1/2</u> miles <u>NW</u> of <u>Glendora</u> (distance) (direction) (nearest town)	<u>Sand</u>	<u>48</u>	<u>58</u>
WELL PURPOSE: <u>irrigation</u> (home, irrigation, municipal, industrial)	<u>Sand + gravel</u>	<u>58</u>	<u>101</u>
WELL COMPLETION DATA:			
(1) diameter (inches) <u>12</u>			
(2) total depth (feet) <u>101'</u>			
(3) static water level (feet) <u>22'</u> below above top of ground.			
(4) casing <u>Steel</u> , <u>61'</u> (material) (depth)			
<u>12</u> If telescope see back. (size)			
(5) screen <u>40'</u> , <u>61'</u> (length) (depth to top)			
<u>12</u> , <u>Mild Steel</u> (size) (material)			
(6) pump <u>40</u> , <u>1,000</u> (HP) (yield gpm)			
<u>Diesel</u> (type power)			
(7) electric log <u>No</u> (yes or no)			
(organization running log)			
(8) how well bottom plugged <u>Plate</u>			
DRILLERS REMARKS:			

CODE 1


DEPT. OF NATURAL RESOURCES
BUREAU OF LAND & WATER RESOURCES

MAY - 4 1984

RECEIVED

If well telescopes please sketch and show depths.

GROUND LEVEL

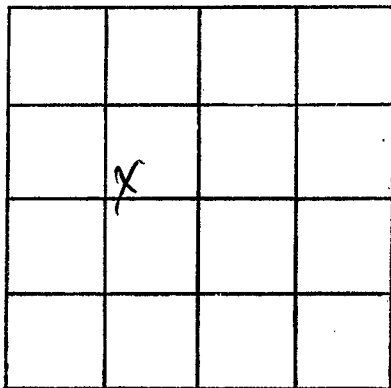

SECTION 31

Please indicate well location X.

ADDITIONAL INFORMATION

If more than one screen,
show locations of each on sketch.