

MISSISSIPPI DEPARTMENT OF NATURAL RESOURCES

Bureau of Land and Water Resources

Southport Mall

P.O. Box 10631

Jackson, Mississippi 39209

WATER WELL DRILLERS LOG

CODED

071  
TALLAHATCHIE  
B-15-84

APRIL 15, 1984 Dyer Well + Irrigation Tallahatchie  
date well completed firm name county well located

LANDOWNER: <u>W. L. Lowe</u>	description of formations encountered		from	to
Glendora, Miss. 38928 (mailing address)	Clay		0	28
	Fine Sand		28	45
	Sand		45	58
	Sand + Gravel		58	76
	Fine Sand		76	86
	Sand + Gravel		86	103
WELL LOCATION: sec. <u>28</u> T. <u>23</u> (N) R. <u>1</u> E S. <u>1</u> <u>1</u> miles <u>West</u> of <u>Glendora</u> (distance) (direction) (nearest town)	CODED			
WELL PURPOSE: <u>Irrigation</u> (home, irrigation, municipal, industrial)				
WELL COMPLETION DATA: (1) diameter (inches) <u>12</u> (2) total depth (feet) <u>103'</u> (3) static water level (feet) <u>21'</u> below above top of ground. (4) casing <u>Steel</u> , <u>63'</u> (material) (depth) <u>12</u> if telescope see back. (size) (5) screen <u>40</u> , <u>63'</u> (length) (depth to top) <u>12</u> , <u>Mild Steel</u> (size) (material) (6) pump <u>40</u> , <u>1000</u> (HP) (yield gpm) <u>Diesel</u> (type power) (7) electric log <u>No</u> (yes or no) (organization running log) (8) how well bottom plugged <u>Plate</u>				

DEPT. OF NATURAL RESOURCES  
BUREAU OF LAND & WATER RESOURCES


MAY - 4 1984

RECEIVED

DRILLERS REMARKS:

If well telescopes please sketch and show depths.

GROUND LEVEL

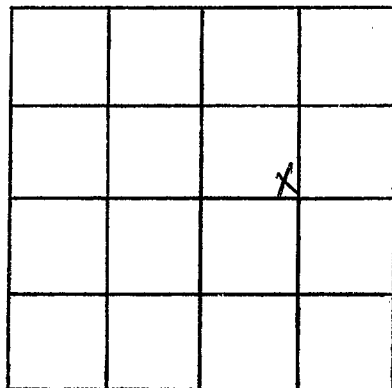

SECTION 28

Please indicate well location X.

ADDITIONAL INFORMATION

If more than one screen,  
show locations of each on sketch.