

**MISSISSIPPI DEPARTMENT OF NATURAL RESOURCES**  
**Bureau of Land and Water Resources**  
 Southport Mall  
 P.O. Box 10631  
 Jackson, Mississippi 39209  
**WATER WELL DRILLERS LOG**

**CODED**

Φ72  
TALLAHATCHIE  
3-21-84

March 24, 1984 Dyer Well and Irrigation Tallahatchie  
 date well completed firm name county well located

| LANDOWNER: <u>W. L. Howe</u>   | description of formations encountered                   | from                               | to                                   |
|--|---|------------------------------------|--------------------------------------|
| <u>Glendora, Miss.</u><br>(mailing address)  | <u>Clay</u><br><u>Fine Sand</u><br><u>Sand + Gravel</u> | <u>0</u><br><u>28</u><br><u>55</u> | <u>28</u><br><u>55</u><br><u>105</u> |
| <b>WELL LOCATION:</b><br>sec. <u>20</u> T <u>23</u> N R <u>1</u> E<br>S <u>5</u> W <u>10</u><br><u>2 1/2</u> miles <u>NW</u> of <u>Glendora</u><br>(distance) (direction) (nearest town)   |   |                                    |                                      |
| <b>WELL PURPOSE:</b> <u>Irrigation</u><br>(home, irrigation, municipal, industrial)  |   |                                    |                                      |
| <b>WELL COMPLETION DATA:</b><br>(1) diameter (inches) <u>16"</u><br>(2) total depth (feet) <u>105'</u><br>(3) static water level (feet) <u>22'</u> below above top of ground.<br>(4) casing <u>Steel</u> (material), (depth) <u>16"</u> if telescope see back. (size)<br>(5) screen <u>40'</u> (length), <u>65'</u> (depth to top)<br><u>16"</u> (size), <u>Mild Steel</u> (material)<br>(6) pump <u>600</u> (HP), <u>3000</u> (yield gpm)<br><u>Electric</u> (type power)<br>(7) electric log <u>No</u> (yes or no)<br>(organization running log)<br>(8) how well bottom plugged <u>Steel Plate</u> |   |                                    |                                      |
| <b>DRILLERS REMARKS:</b>   |   |                                    |                                      |

**CODED**


MISSISSIPPI DEPARTMENT OF NATURAL RESOURCES  
 BUREAU OF LAND & WATER RESOURCES

MAY - 4 1984

**RECEIVED**

If well telescopes please sketch and show depths.

GROUND LEVEL

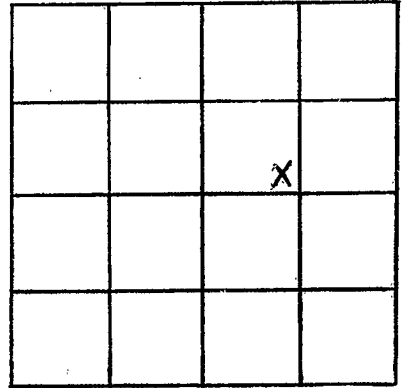

SECTION 20

Please indicate well location X.

ADDITIONAL INFORMATION

If more than one screen,  
show locations of each on sketch.