

MISSISSIPPI DEPARTMENT OF NATURAL RESOURCES

Bureau of Land and Water Resources

Southport Mall

P.O. Box 10631

Jackson, Mississippi 39209

WATER WELL DRILLERS LOG

Q74  
Tallahatchie  
6-4-84

CODED

6-4-84 date well completed  
J+K Irrigation Well firm name  
Tallahatchie county well located

LANDOWNER: Greenwood Irrigation  
(mailing address)

WELL LOCATION:  
sec 27 T-23 N R-1 E  
1 miles E of Glendon  
(distance) (direction) (nearest town)

WELL PURPOSE:  
(home, irrigation, municipal, industrial)

WELL COMPLETION DATA:

(1) diameter (inches) 12  
(2) total depth (feet) 113  
(3) static water level (feet) 23' below top of ground.  
(4) casing steel, 7 7/8 (material), (depth)  
12 (size) if telescope see back.  
(5) screen 40, 73 (length), (depth to top)  
12 (size), steel (material)  
(6) pump 80 (HP), 1100 (yield gpm)  
diesel (type power)  
(7) electric log no (yes or no)  
(organization running log)  
(8) how well bottom plugged plate

description of formations encountered	from	to
CLAY	0	18
FINE SAND	18	46
SAND Gravel	46	113
CODED		

DEPT. OF NATURAL RESOURCES  
BUREAU OF LAND & WATER RESOURCES


JUL 12 1984

RECEIVED

DRILLERS REMARKS:

If well telescopes please sketch and show depths.

GROUND LEVEL

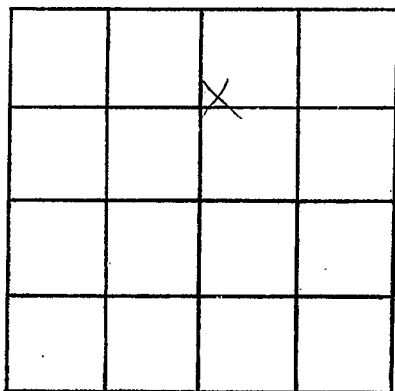

SECTION 27

Please indicate well location X.

ADDITIONAL INFORMATION

If more than one screen,  
show locations of each on sketch.