

**MISSISSIPPI DEPARTMENT OF NATURAL RESOURCES**  
**Bureau of Land and Water Resources**  
 Southport Mall  
 P.O. Box 10631  
 Jackson, Mississippi 39209  
**WATER WELL DRILLERS LOG**

**CODED**

① 76  
 Tallahatchie Co.  
 6-13-84

6/13 1984 Depen Well Tallahatchie  
 date well completed firm name county well located


LANDOWNER:	description of formations encountered	from	to
<u>Jack Flott</u>			
(mailing address)	<u>Clay</u>	<u>0</u>	<u>38</u>
	<u>Hard Sand</u>	<u>38</u>	<u>48</u>
	<u>Sand</u>	<u>48</u>	<u>100</u>
<b>WELL LOCATION:</b> sec. <u>3</u> T. <u>23</u> (N) S. R. <u>1</u> E. (W) <u>2</u> miles <u>N</u> of <u>Swan Lake</u> (distance) (direction) (nearest town)	<u>Sand + Gravel</u>	<u>48</u>	<u>100</u>
<b>WELL PURPOSE:</b> <u>Large</u> (home, irrigation, municipal, industrial)			
<b>WELL COMPLETION DATA:</b>			
(1) diameter (inches) <u>16"</u>			
(2) total depth (feet) <u>100</u>			
(3) static water level (feet) <u>12</u> <u>below</u> top of ground.			
(4) casing <u>STEEL</u> , <u>60</u> (material), (depth) <u>16"</u> if telescope see back. (size)			
(5) screen <u>4ft</u> , <u>60</u> (length), (depth to top) <u>16"</u> , <u>STEEL</u> (size), (material)			
(6) pump <u>10</u> (HP), <u>2200</u> (yield gpm) <u>dies</u> (type power)			
(7) electric log <u>No</u> (yes or no) <u>No</u> (organization running log)			
(8) how well bottom plugged <u>STEEL PLATE</u>			
DRILLERS REMARKS:			

**CODED**

1-16-85  
 J. W. W.

If well telescopes please sketch and show depths.

GROUND LEVEL

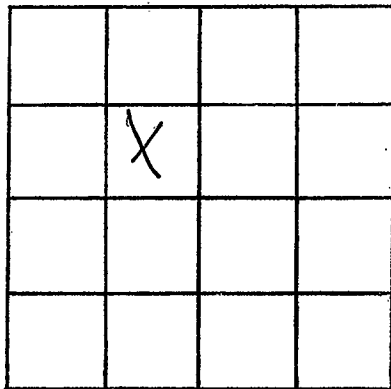

SECTION 3

Please indicate well location X.

ADDITIONAL INFORMATION

If more than one screen,  
show locations of each on sketch.