

TALLAHATCHIE
Q 78

MISSISSIPPI DEPARTMENT OF NATURAL RESOURCES
Bureau of Land and Water Resources
Southport Mall
P.O. Box 10631
Jackson, Mississippi 39209
WATER WELL DRILLERS LOG

CODED

7-28 1985
date well completed

BUTANE GAS COMPANY
OF GREENWOOD

Tallahatchie
county well located

LANDOWNER:
Ralph Hand
Glendora Mo.
(mailing address)

description of formations encountered	from	to
CLAY	0	18
FINE SAND	19	55
SAND pea gravel	55	90
gravel	90	105

WELL LOCATION:
sec. 8 T 23 N R 1 E
S 5
4 miles NW of Glendora
(distance) (direction) (nearest town)

WELL PURPOSE:
(home, irrigation, municipal, industrial)

- WELL COMPLETION DATA:
- (1) diameter (inches) 16"
 - (2) total depth (feet) 105
 - (3) static water level (feet) 10 below above top of ground.
 - (4) casing Steel 65
(material) (depth)
 - 16" if telescope see back.
(size)
 - (5) screen 40' 65'
(length) (depth to top)
 - 16" Steel
(size) (material)
 - (6) pump 60 2000
(HP) (yield gpm)
 - Diene
(type power)
 - (7) electric log No
(yes or no)
 - No
(organization running log)
 - (8) how well bottom plugged
Steel plate


DRILLERS REMARKS:
Robert

RECEIVED
AUG 5 1985

Department of Natural Resources
Bureau of Land & Water Resources

If well telescopes please sketch and show depths.

GROUND LEVEL

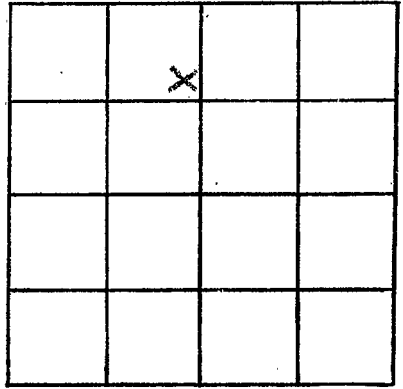

SECTION 8

Please indicate well location X.

ADDITIONAL INFORMATION

If more than one screen,
show locations of each on sketch.