

MISSISSIPPI DEPARTMENT OF NATURAL RESOURCES

Bureau of Land and Water Resources

Southport Mall

P.O. Box 10631

Jackson, Mississippi 39209

WATER WELL DRILLERS LOG

CODED

Tallahatchie
 \$ 80

5-23 1987 BUTANE GAS CO. OF GREENWOOD Tallahatchie
 date well completed firm name county well located

LANDOWNER:	description of formations encountered	from	to
W.G. Flautt			
SWAN LAKE (mailing address)	CLAY	0	18
	SAND	18	40
	SAND + GRAVEL	40	93
WELL LOCATION:			
sec. 15 T. 23 N R. 1 W			
1 miles SOUTH of SWAN LAKE (distance) (direction) (nearest town)			
WELL PURPOSE:			
FRP (home, irrigation, municipal, industrial)			
WELL COMPLETION DATA:			
(1) diameter (inches) 8"			
(2) total depth (feet) 93			
(3) static water level (feet) 20 below top of ground.			
(4) casing PVC, 53' (depth) 8" (size) if telescope see back.			
(5) screen 40' (length), 53' (depth to top) 8" (size), PVC (material)			
(6) pump 10 (HP), 500 (yield gpm) Elec. (type power)			
(7) electric log NO (yes or no)			
(organization running log)			
(8) how well bottom plugged PVC Cap			

CODED

RECEIVED


JUN 03 1987

Department of Natural Resources
 Bureau of Land & Water Resources

DRILLERS REMARKS:

If well telescopes please sketch and show depths.

GROUND LEVEL

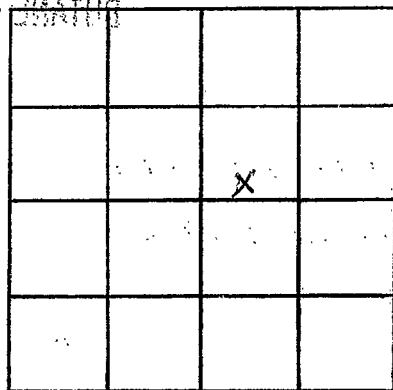

SECTION 15

Please indicate well location X.

ADDITIONAL INFORMATION

If more than one screen, show locations of each on sketch.