

Tallahatchie
 \$ 81

MISSISSIPPI DEPARTMENT OF NATURAL RESOURCES
 Bureau of Land and Water Resources
 Southport Mall
 P.O. Box 10631
 Jackson, Mississippi 39209
 WATER WELL DRILLERS LOG

CODED

5-28 1987 BUTANE GAS CO. OF GREENWOOD Tallahatchie
 date well completed firm name county well located

LANDOWNER:
 W.L. Howe
 Glendora
 (mailing address)

description of formations encountered	from	to
	CLAY	0
FINE SAND	12	50
COARSE SAND	50	65
SAND + Pea GRAVEL	65	90
GRAVEL	90	105

WELL LOCATION:
 sec. 21 T 23 N R 1 E
 S (W)
 1 miles N of GLENDORA
 (distance) (direction) (nearest town)

CODED

WELL PURPOSE: IRR
 (home, irrigation, municipal, industrial)

- WELL COMPLETION DATA:
- (1) diameter (inches) 16
 - (2) total depth (feet) 105
 - (3) static water level (feet) 23 below above top of ground.
 - (4) casing Steel, 65 (material) (depth), 16" (size) if telescope see back.
 - (5) screen 40, 65 (length) (depth to top), 16" (size), Steel (material)
 - (6) pump 84, 1400 (HP) (yield gpm), Diesel (type power)
 - (7) electric log No (yes or no)
- (organization running log)

RECEIVED
 JUN 03 1987
 Department of Natural Resources
 Bureau of Land & Water Resources


(8) how well bottom plugged Steel Plate

DRILLERS REMARKS:

If well telescopes please sketch and show depths.

GROUND LEVEL

CONTINUED TO 101 240 MATLIN

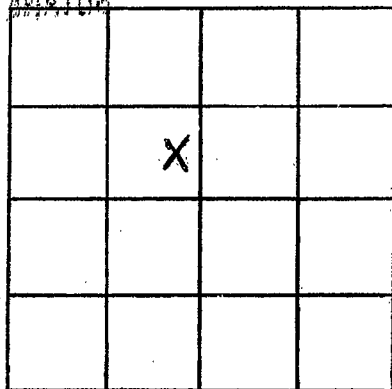

SECTION 21

Please indicate well location X.

ADDITIONAL INFORMATION

If more than one screen,
show locations of each on sketch.