

MISSISSIPPI DEPARTMENT OF NATURAL RESOURCES
 Bureau of Land and Water Resources
 Southport Mall
 P.O. Box 10631
 Jackson, Mississippi 39209
WATER WELL DRILLERS LOG


CODED

Tallahatchie
 # 82

5-6 1987 BUTANE GAS CO. OF GREENWOOD Tallahatchie
 date well completed firm name county well located

LANDOWNER:	description of formations encountered	from	to
Ralph Hand			
Glendora (mailing address)	CLAY SAND	0	10 30
WELL LOCATION: sec 8 T 23 N R 1 E 2 1/2 miles NORTH of GLENDORA (distance) (direction) (nearest town)	SAND & GRAVEL	30	103
WELL PURPOSE: <u>DRR</u> (home, irrigation, municipal, industrial)			
WELL COMPLETION DATA:			
(1) diameter (inches) <u>12"</u>			
(2) total depth (feet) <u>103'</u>			
(3) static water level (feet) <u>20</u> below above top of ground.			
(4) casing <u>Steel</u> , <u>63'</u> , (material) (depth) <u>12"</u> if telescope see back. (size)			
(5) screen <u>40'</u> , <u>63'</u> (length) (depth to top) <u>12"</u> , <u>Steel</u> (size) (material)			
(6) pump <u>30</u> <u>1200</u> (HP) (yield gpm) <u>DIESEL</u> (type power)			
(7) electric log <u>NO</u> (yes or no)			
(organization running log)			
(8) how well bottom plugged <u>Steel Plate</u>			

CODED

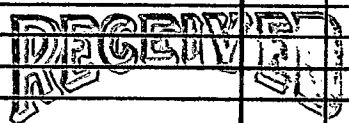

JUN 03 1987

Department of Natural Resources
 Bureau of Land & Water Resources

DRILLERS REMARKS:

If well telescopes please sketch and show depths.

GROUND LEVEL

X			

SECTION 6

Please indicate well location X.

ADDITIONAL INFORMATION

If more than one screen, show locations of each on sketch.