

MISSISSIPPI DEPARTMENT OF NATURAL RESOURCES

Bureau of Land and Water Resources

Southport Mall

P.O. Box 10631

CODED

Jackson, Mississippi 39209

WATER WELL DRILLERS LOG

Tallahatchie
 # 83

5-6

1987 BUTANE GAS CO. OF GREENWOOD

Tallahatchie

date well completed

firm name

county well located

LANDOWNER:
 Ralph H Hand
 Glendora
 (mailing address)

description of formations encountered	from	to
SAND	0	25
SAND	25	35
SAND + GRAVEL	35	90

WELL LOCATION:
 sec. 6 T 23 N R 1 E
 4 1/4 miles NORTH of GLENDORA
 (distance) (direction) (nearest town)

WELL PURPOSE: DRILL
 (home, irrigation, municipal, industrial)

- WELL COMPLETION DATA:
- (1) diameter (inches) 12"
 - (2) total depth (feet) 90
 - (3) static water level (feet) 20 below above top of ground.
 - (4) casing Steel, 50,
 (material) (depth)
12"
 (size) if telescope see back.
 - (5) screen 40', 50
 (length) (depth to top)
12", Steel
 (size) (material)
 - (6) pump 40 1500
 (HP) (yield gpm)
DIESEL
 (type power)
 - (7) electric log No
 (yes or no)

(organization running log)

(8) how well bottom plugged
Steel plate

DRILLERS REMARKS:

CODED


RECEIVED

JUN 03 1987

Department of Natural Resources
 Bureau of Land & Water Resources

If well telescopes please sketch and show depths.

GROUND LEVEL

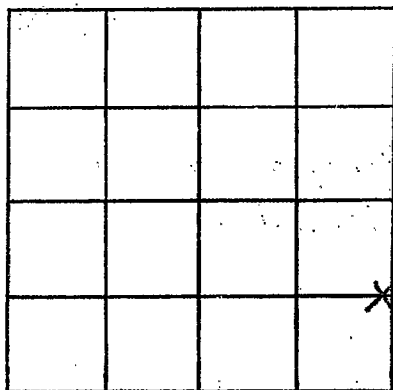

SECTION 6

Please indicate well location X.

ADDITIONAL INFORMATION

If more than one screen,
show locations of each on sketch.