

MISSISSIPPI DEPARTMENT OF NATURAL RESOURCES

Bureau of Land and Water Resources

Southport Mall

P.O. Box 10631

Jackson, Mississippi 39209

WATER WELL DRILLERS LOG

Permit Applied For
 Φ 85
 CODED

6-23 1988 Dyer Well Tallahatchie
 date well completed firm name county well located

LANDOWNER: Swan Lake
 Box 335
 Swan Lake Ms. 38958
 (mailing address)

description of formations encountered	from	to
Clay	0	28
Fine Sand	28	66
M Sand & Gravel	66	70
Fine Sand	70	80
Sand & Gravel	80	100

WELL LOCATION:
 sec. 10 T 23 N R 1 E S W
 1 miles N of Swan Lake
 (distance) (direction) (nearest town)

WELL PURPOSE: Irrigation
 (home, irrigation, municipal, industrial)

- WELL COMPLETION DATA:
- (1) diameter (inches) 10"
 - (2) total depth (feet) 100'
 - (3) static water level (feet) _____ below above top of ground.
 - (4) casing steel (material), _____ (depth),
 10" If telescope see back.
 (size)
 - (5) screen 40' (length), _____ (depth to top)
 10" (size) _____ (material)
 - (6) pump 10 (HP) _____ (yield gpm)
 Elec (type power)
 - (7) electric log No (yes or no)
 Nov E (organization running log)
 - (8) how well bottom plugged Plate

RECEIVED


JUL 11 1988

Department of Natural Resources
 Bureau of Land & Water Resources

DRILLERS REMARKS:

If well telescopes please sketch and show depths.

GROUND LEVEL

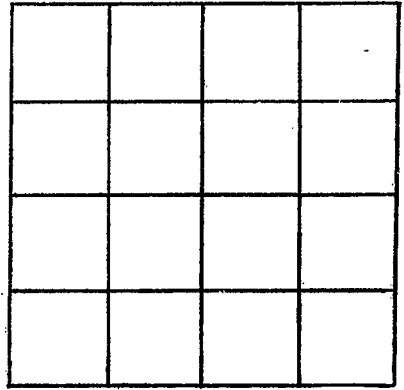

SECTION _____

Please indicate well location X.

ADDITIONAL INFORMATION

If more than one screen,
show locations of each on sketch.