

STATE WELL REPORT

140

County: Tallahatchie
 Permit #: MS-GW-50658
 Driller: Chad Watson
 Date drilling completed: 3/15/19

Part 1
Driller's Log
 Mississippi Department of Environmental Quality
 Office of Land and Water Resources
 P.O. Box 2309
 Jackson, MS 39225-2309
 (601)961-5555
 (601)961-5228 (fax)

For Office Use Only:

Well #: 0 146
 Aquifer: _____
 E-Log #: _____

State Law requires that this report be prepared by the license holder responsible for the work and filed with the Department at the above address within 30 days of completion of drilling of the well or borehole.

Well Owner Information <small>(Landowner if borehole is not for a water well)</small>	Well or Borehole Location
Owner Name: <u>Stevenson Family Plus</u>	Latitude: <u>33 49 3</u> Longitude: <u>90 14 47</u>
Mailing Address: <u>PO Box 230</u>	Method of Lat/Long (check one): Conventional Survey _____ USGS quad _____, Hand-held GPS <input checked="" type="checkbox"/> , Survey-grade GPS _____
<u>Glendora</u> MS <u>38928</u>	<u>SW 1/4 NE 1/4, Sec 36 T 23N R 01W</u>
City State Zip Code	<u>5</u> Miles <u>SE</u> of <u>Glendora</u>
Telephone No. (____) _____	(Distance) (Direction) (Nearest Town)

Well / Borehole Data

Date drilling started: 3/15/19 Date drilling completed: 3/15/19 Hole depth: 15 Hole diameter: 24

Location of the source of any surface water used for drilling: Drainage Ditch in Field

Method of dosing and volume of Chlorine used in drilling and development: _____

Logs run (check all applicable): log run Electric Gamma Ray Density Sonic Neutron Other: _____

Name of organization running log(s): _____

Purpose of borehole (check one): Water Well Geotechnical/Geological Investigation Ground Source Heat Pump
 Seismic Survey Other (describe) _____

If drilling is not related to water well construction, skip the remainder of this block

Purpose of Well (check all applicable): Home Industrial Public Supply Irrigation Fish Culture

Other (describe): _____

If a flowing well, method of flow regulation: Valve _____ Other (describe) _____

Static Water Level: 17 feet above or below land surface Date measured: 3/16/19
(check one)

Method of measurement (check one) Steel tape Electric tape Air line other (describe): _____

Well depth: 115 Well grouted to a depth of: 10 feet Type of grout (check one) Neat Cement Bentonite Mix

Casing length: 75 feet Casing diameter: 16 inches Type of casing: PVC

Screen length: 40 feet Screen diameter: 16 inches Type of screen: PVC

Screen slot size: 0.032 inches Setting depth: From 115 feet to 75 feet

Type of completion (check all applicable) gravel packed Underreamed Open hole Natural Development

Other (describe): _____

Top of lap pipe or reduction in casing: _____ feet


If telescoped or more than one screen, describe on next page

RECEIVED
 JUL 23 2019
 BY OLWR

County: Taliahatchee
 Permit #: CGW-50658

For Office Use Only:
 Well #: _____

The sketch below only required for water wells
 If well telescopes, show depths on sketch.

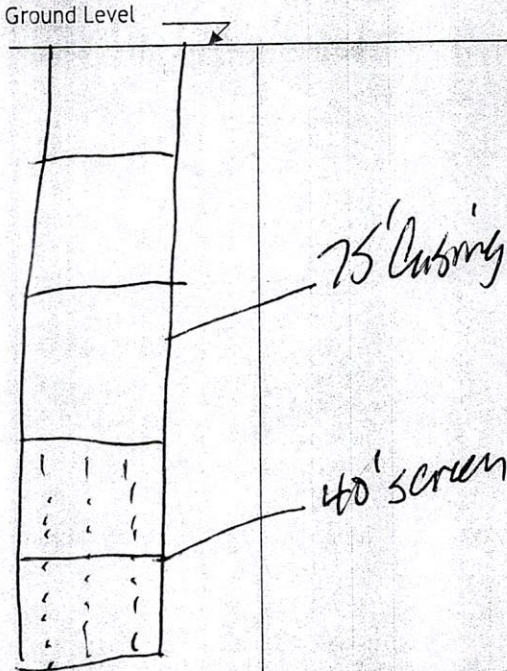

If more than one screen, show location of each on sketch

Description of formations encountered must be provided for all wells
 and boreholes, unless specifically exempted by regulations

Description of Formations Encountered	From (depth)	To (depth)
Topsoil / Clay	Ground level	15
Sand	16	25
	26	35
	36	45
	46	55
Gravel / Sand	56	65
	66	75
	76	85
	86	95
Gravel / clay	96	105
	106	115

- Sketch the property layout and include the following:
- 1) the well location
 - 2) any permanent structures on the property that may aid in locating the well
 - 3) any roads, power lines, or other items that may aid in locating the property and the well
 - 4) north arrow

RECEIVED
 JUL 23 2019
 BY OLWR

Landowner Name: _____

I HEREBY CERTIFY that the well/borehole was drilled, constructed, and completed in accordance with all applicable requirements of the Mississippi Department of Environmental Quality and the Mississippi Department of Health regulations, if applicable, and state laws.

Chad Mattox LINE 8243
 Print Name of Responsible Licensee and License No.

5/14/19
 Date

Chad Mattox
 Signature of Licensee

STATE WELL REPORT

Part 2

Pump Installer's Completion Report

Mississippi Department of Environmental Quality
Office of Land and Water Resources
P.O. Box 2309
Jackson, MS 39225-2309
(601)961-5210
(601) 360-0535 (fax)

For Office Use Only:

Well #: 0146

Aquifer: _____

County: Talbot
 Permit #: MS-LW-50658
 Driller: Chad Mathis
 Date completed: 3/14/19
Copy information from block on Part 1

This part of the report must be completed by a licensed water well contractor or a licensed pump installer. A copy of Part 1 of the report must be attached and both parts filed with the Department at the above address within 30 days of well completion.

Well Owner Information			Well Location	
Owner Name: <u>Standaunt Family Atns.</u>			Latitude: <u>33 49 3</u>	Longitude: <u>90 14 47</u>
Mailing Address: <u>PO Box 230</u>			Method of Lat/Long (check one): Conventional Survey _____, USGS quad _____, Hand-held GPS <input checked="" type="checkbox"/> , Survey-grade GPS _____	
<u>Glendora</u>	<u>MS</u>	<u>38928</u>	<u>SW 1/4 NE 1/4, Sec 36 T 23 N R 01 W</u>	
City	State	Zip Code	<u>5</u> Miles <u>SE</u> of <u>Glendora</u>	
Telephone No. (____) _____			(Distance)	(Direction) (Nearest Town)

Pump Type (check one)

Submersible Turbine Air Lift Centrifugal Flowing Well Jet Piston Rotary Other (describe): _____

Date Pump Installed: 3/14/19 Rated Pump Capacity: 2500 Gallons Per Minute

Is This Pump (check one): New Repaired Replacement

Power Type (check one)

Electric Diesel Gasoline Natural Gas Tractor PTO Windmill Other (describe): _____

Horse Power Rating of Motor: 400 Setting Depth: 70 feet Number of Stages: 2

Pump Test Data for Non Flowing Well

Date Well Tested: _____ Duration of Pump Test (minimum 4 hours): _____ hours

Static Water Level (A): _____ Feet Below Land Surface Pumping Water Level (B): _____ Feet Below Land Surface

Drawdown [(B) - (A)]: _____ Feet Below Land Surface Test Pumping Rate: _____ Gallons Per Minute

Method of measurement (check one): Steel tape Electric tape Air line Other (describe): _____

Pump Test Data for Flowing Well

Measured shut in head: _____ feet.

Well yielded _____ GPM with a drawdown of _____ feet after _____ hours of pumping

Meter Installation

Meter Manufacturer: _____ Meter Serial Number: _____

Meter Model Number/Name: _____ Type of Meter: _____

Totalizer Register Unit and Multiplier Factor (AF x .001, gal x 1000, etc): _____

Installation Date: _____ Meter installed by: _____

Is This Meter (check one): New Repaired Replacement

Important: By submitting the above information you are certifying that this meter was installed to manufacturer standards. For agricultural wells, a list of approved meters is on the MDEQ website.

I HEREBY CERTIFY that the above statements are true to the best of my knowledge.

Chad Mathis WR-8243 5/14/19 Chad Mathis

Print Name of Pump Installer and License No. (if applicable) Date Signature of Pump Installer

RECEIVED
JUL 23 2019
BY OLWR

STATE Of MISSISSIPPI
Department Of Environmental Quality
Office Of Land And Water Resources
P.O.Box 2309
Jackson, Mississippi 39225

PERMIT
TO DIVERT OR WITHDRAW FOR BENEFICIAL USE THE PUBLIC WATERS

This permit is issued to the landowner named below in accordance with the provisions of the Mississippi Water Laws, Mississippi Code Sections 51-3-1, et seq.(1972, as amended), and the regulations and standards as promulgated thereunder. Whether or not specifically named in this permit or in the applications for this permit, anyone using water from the diversion/withdrawal point described below shall do so in compliance with the provisions of this permit. Neither this permit, nor any authority conferred hereby, may be sold, conveyed, encumbered, assigned or otherwise aliened, for any period of time or under any conditions whatsoever. This permit may not be modified, transferred, or revoked without prior action by the Permit Board. Any attempts to modify, transfer or revoke this permit, or to take any other action on this permit, shall be invalid and unenforceable and may result in immediate revocation or suspension of this permit. The holder of this permit shall at all times be responsible for adherence to the terms and conditions of this permit. No agreement between the permit holder and any other party shall affect the obligations and liabilities of the permit holder. Water use under this permit is allowed only when the streamflow or lake level elevation (whichever, if any, is applicable) is above the established minimum, pursuant to Mississippi Code Section 51-3-7. Authorization is hereby granted to divert/withdraw water for the beneficial use designated herein, and for no other purpose, subject to the following terms, conditions, and limitations:

Permit Number: MS-GW-50658 Total Permitted Acreage: 141

Landowner Name: STURDIVANT FAMILY PARTNERS LP

Landowner Address: PO BOX 230
GLENDORA, MS 38928

Source of Water: MISSISSIPPI RIVER VALLEY ALLUVIAL AQUIFER

Beneficial Use(s): IRRIGATION

Diversion/Withdrawal Location: SW 1/4 of the NE 1/4 Section: 36 Township: 23N Range: 01W

County: TALLAHATCHIE Quad: PHILIPP

Permitted Acreage: Irrigation: 141 Fish Culture: 0 Wildlife Management: 0

Maximum Volume: See Special Terms and Conditions (Attachment 1)

Applicant Name: DUE WEST FARM

Applicant Address: PO BOX 230
GLENDORA, MS 38928

Date Permit Issued: 01/11/2019

Date Permit Expires: 01/11/2024

Date Permit Modified:

Date Permit ReIssued:


This permit shall be deemed null and void if construction has not begun within one (1) year of the permit issue date.

SPECIAL TERMS AND CONDITIONS 1:

The permitted water volume must be reduced by the amount of water applied to the same acreage from other permitted point(s): GW-38360, GW-30359

SPECIAL TERMS AND CONDITIONS 2:

See Attachment I which is hereby declared part of this permit.

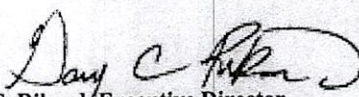
Gary C. Rikard, Executive Director
Mississippi Department Of Environmental Quality

RECEIVED
JUL 23 2019
BY OLWR