

Tallahatchie
 2000
 9-29-76

MISSISSIPPI
 BOARD OF WATER COMMISSIONERS
 416 North State Street
 Jackson, Mississippi 39201

WATER WELL DRILLERS LOG

9-29-76 19 BUTANE GAS CO. OF GREENWOOD Tallahatchie
 date well completed firm name county well located

LANDOWNER:
 MRS. M. B. Lowe
 Glenora
 (mailing address)

WELL LOCATION:
 sec. 22 T. 23 N. R. 1 E. S. W.
 1 miles N of Glenora
 (distance) (direction) (nearest town)

WELL PURPOSE: Home
 (home, irrigation, municipal, industrial)

WELL COMPLETION DATA:
 (1) diameter (inches) 4 X ✓
 (2) total depth (feet) 860
 (3) static water level (feet) 3 below above top of ground.
 (4) casing Steel 840 (material) (depth)
 4 X 2 (size) if telescope see back.
 (5) screen 20' 840 (length) (depth to top)
 2" stainless (size) (material)
 (6) pump 1 20 (HP) (yield gpm)
 Elec (type power)
 (7) electric log no (yes or no)
 (organization running log)

(8) how well bottom plugged
 Lead Plug
 DRILLERS REMARKS:

description of formations encountered	from	to
CLAY	0	16
SAND	16	60
SAND & CLAY	60	80
SAND & GRAVEL	80	135
CLAY	135	160
SAND & CLAY	160	300
SAND	300	360
CLAY	360	400
SAND & SHALE & CLAY	400	606
BROWN SHALE	606	690
CLAY	690	725
SAND & SHALE	725	745
White sand	745	860

RECEIVED
 OCT - 6 1976

MISS. BD. OF WATER COMM.


If well telescopes please sketch and show depths.

GROUND LEVEL

105' - 4" CASING →

73' - 1" - 2" CASING →

20' - 2" SCREEN →

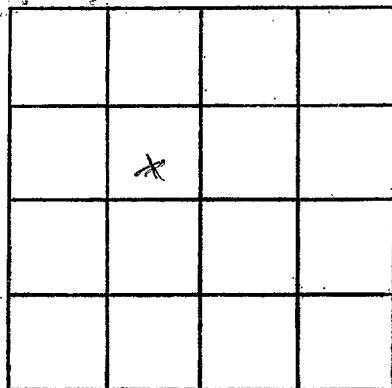

SECTION 22

Please indicate well location X.

ADDITIONAL INFORMATION

If more than one screen, show locations of each on sketch.