

MISSISSIPPI DEPARTMENT OF NATURAL RESOURCES
Bureau of Land and Water Resources

P.O. Box 10631

Jackson, Mississippi 39209
WATER WELL DRILLERS LOG

108D

COUNTY WELL LOCATED: Tallahatchie

WELL NUMBER <u>Q</u>	CODED	PERMIT NUMBER
DATE WELL COMPLETED <u>2004</u> <u>5-14-89</u>		NAME OF DRILLING FIRM <u>Butane Gas Co.</u>

NAME & MAILING ADDRESS OF LANDOWNER
Clyton Bishop
P.O. Box 60
Glendora, Mo 38928

WELL LOCATION: SEC 22 TOWNSHIP 23 RANGE 1
N S E W

DISTANCE 5 Miles DIRECTION NE of NEAREST TOWN Hebron

OTHER LANDMARK

WELL PURPOSE: Home, Irrigation, Municipal, Industrial, Fish Pond, etc.

PUMP DATA

PUMP TYPE (Circle One):
Submersible Jet Flowing Well,
Other (Describe) _____

POWER TYPE (Circle One):
Electric Tractor, Gasoline, Butane,
Other (Describe) _____ H/P 10

Pump Capacity (GPM) <u>600</u>	No. of Stages <u>1</u>	Setting Depth <u>60</u> FT.
-----------------------------------	---------------------------	--------------------------------

PUMP TEST

Well yielded 600 GPM with
a drawdown of 13 ft.
after 2 hours of pumping

WELL DATA

Well Depth <u>100</u>	Casing Diameter (In.) <u>8"</u>	Casing Length (Ft.) <u>60</u>
Type of Casing <u>PVC</u>	Hole Depth <u>100</u>	Depth to Static Water Level <u>29</u>

TYPE OF COMPLETION: (Circle One or More):
Gravel Packed Underreamed, Telescoped,
Natural Development, Open Hole, Other
(Describe) _____

Top of Lap Pipe or Reduction in Casing

FEET IF TELESCOPED OR MORE THAN ONE SCREEN: USE BACK PAGE

LOG DATA

TYPE OF LOG RUN (Circle One): No Log Run,
Electric, Gamma Ray, Density, Sonic, Neutron,
Other (Describe) _____

Name of Organization Running Log

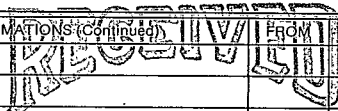
SCREEN DATA

Diameter - Inches <u>8"</u>	Length - Feet <u>40'</u>	Slot Size - Inches <u>30T</u>
Screen Type <u>PVC</u>	Depth to Bottom - Feet <u>100</u>	

GEOLOGIC DATA (Office Use Only)

Surface Elev.	Geologic Unit	Unit Thickness	Depth to Top
Subs. SWL	Date	Analysis	Aquifer Test

Driller's Remarks

DESCRIPTION OF FORMATIONS ENCOUNTERED	FROM	TO	FORMATIONS (Continued)	FROM	TO
<u>clay</u>	<u>18</u>	<u>18</u>	 <u>JUN 19 1989</u> Department of Natural Resources Bureau of Land & Water Resources		
<u>fine sand</u>	<u>18</u>	<u>41</u>			
<u>coarse sand</u>	<u>41</u>	<u>90</u>			
<u>coarse sand & gravel</u>	<u>90</u>	<u>100</u>			

IF MORE SPACE IS NEEDED, USE BACK

If well telescopes please sketch and show depths.

GROUND LEVEL

1500' 100'

100' 200'

100'	200'	300'	400'
50'	100'	150'	200'
200'	300'	400'	500'
100'	200'	300'	400'

SECTION _____

Please indicate well location X.

ADDITIONAL INFORMATION

If more than one screen, show location of each on sketch.