

TALLAHATCHIE

0 2008

04-28-79

MS-6W-02485

4-28-79
date well completed

MISSISSIPPI
BOARD OF WATER COMMISSIONERS
416 North State Street
Jackson, Mississippi 39201

WATER WELL DRILLERS LOG
BUTANE GAS COMPANY
OF GREENWOOD

Tallahatchie
county well located

LANDOWNER:	description of formations encountered	from	to
B+S Planting Co. Glendora (mailing address)			
WELL LOCATION: 23 ⁿ sec. <u>25</u> T. <u>2</u> N R. <u>1</u> E S. <u>5</u> W 2 1/2 miles NE of Glendora (distance) (direction) (nearest town)			
WELL PURPOSE: <u>IRR</u> (home, irrigation, municipal, industrial)			
WELL COMPLETION DATA:			
(1) diameter (inches) <u>16"</u>			
(2) total depth (feet) <u>110</u>			
(3) static water level (feet) <u>70</u> below above: top of ground.			
(4) casing <u>Steel</u> , <u>70</u> , (material) (depth) <u>16</u> if telescope see back. (size)			
(5) screen <u>40</u> , <u>70</u> (length) (depth to top) <u>16</u> , <u>Steel</u> (size) (material)			
(6) pump <u>50</u> , <u>2000</u> (HP) (yield gpm) <u>Propane</u> (type power)			
(7) electric log <u>No</u> (yes or no) (organization running log)			
(8) how well bottom plugged <u>Steel Plate</u>			
DRILLERS REMARKS:			


Miss. Board of Water Comm.

MAY - 9 1979

RECEIVED

If well telescopes please sketch and show depths.

GROUND LEVEL

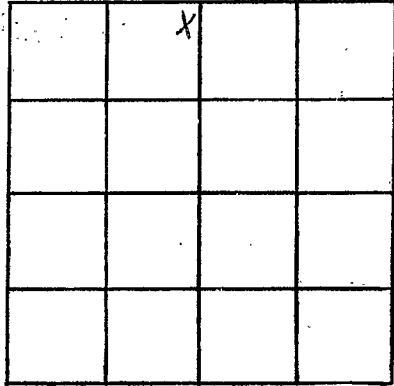

SECTION 25

Please indicate well location X.

ADDITIONAL INFORMATION

If more than one screen, show locations of each on sketch.