

MISSISSIPPI DEPARTMENT OF NATURAL RESOURCES
Bureau of Land and Water Resources
 Southport Mall
 P.O. Box 10631
 Jackson, Mississippi 39209
WATER WELL DRILLERS LOG

Tallahatchie
02010
MS-60-03461

④
 03461

11-016 19 81 Dyer Wells Irrigation Tallahatchie
 date well completed firm name county well located

LANDOWNER: Mike Sturdivant

description of formations encountered	from	to
	to p soil	0
H p sand	13	23
med sand	23	43
COARSE - gr. silt gravel	43	102

Glendora, Ms.
 (mailing address)

WELL LOCATION:
 sec. 18 T. 23 (N) R. 2 E
3 miles NW of Glendora
 (distance) (direction) (nearest town)

WELL PURPOSE: Irrigation
 (home, irrigation, municipal, industrial)

WELL COMPLETION DATA:

- (1) diameter (inches) 16"
- (2) total depth (feet) 102
- (3) static water level (feet) 18 below above top of ground.
- (4) casing Steel, 62,
 (material) (depth)
16" if telescope see back.
 (size)
- (5) screen 40',
 (length) (depth to top)
16", Mild Steel
 (size) (material)
- (6) pump 125 1600
 (HP) (yield gpm)
Diesel
 (type power)
- (7) electric log No
 (yes or no)
- (organization running log)
- (8) how well bottom plugged Plate


DRILLERS REMARKS:

DEPT. OF NATURAL RESOURCES
 BUREAU OF LAND & WATER RESOURCES

MAY 19 1992
RECEIVED

If well telescopes please sketch and show depths.

GROUND LEVEL

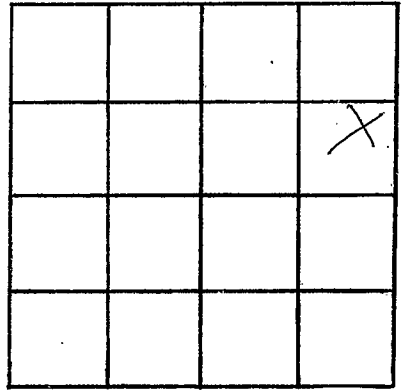

SECTION 18

Please indicate well location X.

ADDITIONAL INFORMATION

If more than one screen,
show locations of each on sketch.