

MISSISSIPPI DEPARTMENT OF NATURAL RESOURCES

Bureau of Land and Water Resources

Southport Mall

P.O. Box 10631

Jackson, Mississippi 39209

WATER WELL DRILLERS LOG

3

Tallahatchie
0 2011
MS-6W-03462

11-11 1981 Dyer Well + Irrigation Tallahatchie
 date well completed firm name county well located


LANDOWNER: <u>Mike Sturdivant</u>	description of formations encountered	from	to
<u>Glendora, Ms</u> (mailing address)			
WELL LOCATION: sec <u>29</u> T <u>23</u> N R <u>1</u> E S <u>W</u> <u>2 1/2</u> miles <u>W</u> of <u>Glendora</u> (distance) (direction) (nearest town)	top soil H.P. sand med sand coarse sand	0 13 33 43	13 33 43 103
WELL PURPOSE: <u>Irrigation</u> (home, irrigation, municipal, industrial)			
WELL COMPLETION DATA: (1) diameter (inches) <u>16"</u> (2) total depth (feet) <u>103</u> (3) static water level (feet) <u>18</u> below above top of ground. (4) casing <u>Steel</u> , <u>63</u> (material) (depth) <u>16"</u> (size) if telescope see back. (5) screen <u>40'</u> (length) (depth to top) <u>16"</u> , <u>Mild Steel</u> (size) (material) (6) pump <u>80</u> <u>1500</u> (HP) (yield gpm) <u>Diesel</u> (type power) (7) electric log <u>No</u> (yes or no) (organization running log) (8) how well bottom plugged <u>Plate</u>			
DRILLERS REMARKS:			

DEPT. OF NATURAL RESOURCES
 BUREAU OF LAND & WATER RESOURCES

MAY 19 1982
 RECEIVED

If well telescopes please sketch and show depths.

GROUND LEVEL

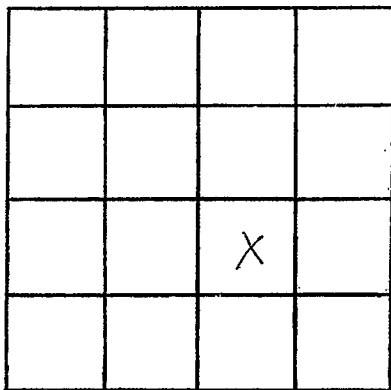

SECTION 29

Please indicate well location X.

ADDITIONAL INFORMATION

If more than one screen, show locations of each on sketch.