

MISSISSIPPI DEPARTMENT OF NATURAL RESOURCES

Bureau of Land and Water Resources

Southport Mall

P.O. Box 10631

Jackson, Mississippi 39209

WATER WELL DRILLERS LOG

Tallahatchie  
 2012  
 MS-6W-03463

(2)

11-29-81 1981 Peyer Well + Irrigation Tallahatchie  
 date well completed firm name county well located

LANDOWNER: <u>Mike Stundevant</u>	description of formations encountered	depth	
		from	to
<u>Glendora, Ms</u> (mailing address)	<u>top soil</u>	0	13
	<u>BROWN SAND</u>	13	23
	<u>H.P. SAND</u>	13	43
	<u>COARSE SAND LUMEN</u>	43	107
<b>WELL LOCATION:</b>			
sec <u>29</u> T <u>23</u> (N) S R <u>1</u> E (W)			
<u>2 1/4</u> miles <u>SW</u> of <u>Glendora</u> (distance) (direction) (nearest town)			
<b>WELL PURPOSE:</b> <u>Irrigation</u> (home, irrigation, municipal, industrial)			
<b>WELL COMPLETION DATA:</b>			
(1) diameter (inches) <u>16"</u>			
(2) total depth (feet) <u>107</u>			
(3) static water level (feet) <u>18</u> below above top of ground.			
(4) casing <u>steel</u> , <u>67</u> , (material) (depth), <u>16"</u> if telescope see back. (size)			
(5) screen <u>40'</u> , (length) (depth to top) <u>16"</u> , <u>Mild Steel</u> (size) (material)			
(6) pump <u>80</u> , <u>1500</u> (HP) (yield gpm) <u>Diesel</u> (type power)			
(7) electric log <u>No</u> (yes or no) <u></u> (organization running log)			
(8) how well bottom plugged <u>Plate</u>			
DRILLERS REMARKS:			


DEPT. OF NATURAL RESOURCES  
 BUREAU OF LAND & WATER RESOURCES

MAY 19 1982

RECEIVED

If well telescopes please sketch and show depths.

GROUND LEVEL

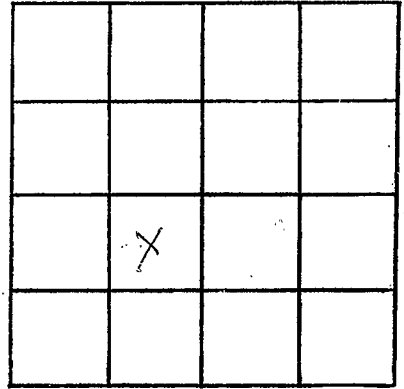

SECTION 29

Please indicate well location X.

ADDITIONAL INFORMATION

If more than one screen,  
show locations of each on sketch.