

MISSISSIPPI DEPARTMENT OF NATURAL RESOURCES  
Bureau of Land and Water Resources

Southport Mall  
P.O. Box 10631

Jackson, Mississippi 39209  
**WATER WELL DRILLERS LOG**

**BUTANE GAS CO. OF GREENWOOD**  
POST OFFICE BOX 1135  
**GREENWOOD, MISS. 38930**

11-18 1981  
date well completed

Tallahatchie  
county well located

LANDOWNER:	description of formations encountered	from	to
Mrs. Dan Reynolds  (mailing address)  <b>WELL LOCATION:</b> sec. <u>25</u> T <u>23</u> N R <u>1</u> E W <u>3</u> miles <u>E</u> of <u>Glendora</u> (distance) (direction) (nearest town)  <b>WELL PURPOSE:</b> <u>irrigation</u> (home, irrigation, municipal, industrial)  <b>WELL COMPLETION DATA:</b> (1) diameter (inches) <u>16"</u> (2) total depth (feet) <u>100'</u> (3) static water level (feet) <u>30</u> <sup>below</sup> <del>above</del> top of ground. (4) casing <u>Steel</u> , <u>60</u> (material) (depth) <u>16"</u> if telescope see back. (size) (5) screen <u>40'</u> , <u>60'</u> (length) (depth to top) <u>16"</u> , <u>Steel</u> (size) (material) (6) pump <u>1</u> , <u>30</u> (HP) (yield gpm) <u>Electric</u> (type power) (7) electric log <u>no</u> (yes or no) <u>no</u> (organization running log) (8) how well bottom plugged <u>Steel plate</u>  <b>DRILLERS REMARKS:</b> <u>Earl</u>	<u>hard sand</u> 10 30 <u>sand</u> 30 50 <u>sand + P gravel</u> 50 70 <u>sand + gravel</u> 70 84 <u>Clay</u> 84 86 <u>fine sand</u> 86 88 <u>sand + gravel</u> 88 90 <u>sand + gravel</u> 90 100 <u>Rock</u>		


DEPT. OF NATURAL RESOURCES  
BUREAU OF LAND & WATER RESOURCES

DEC 29 1981

RECEIVED

If well telescopes please sketch and show depths.

GROUND LEVEL

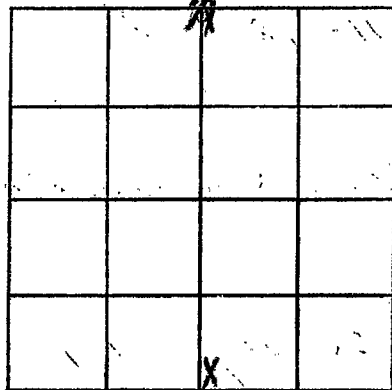

SECTION 25

Please indicate well location X.

ADDITIONAL INFORMATION

If more than one screen,  
show locations of each on sketch.