

MISSISSIPPI DEPARTMENT OF NATURAL RESOURCES
Bureau of Land and Water Resources
 Southport Mall
 P.O. Box 10631
 Jackson, Mississippi 39209
WATER WELL DRILLERS LOG

Jallachatchee
0 2015
MS-GW-01947

3-23 19 82 Dyer Well Jallatchee
 date well completed firm name county well located

LANDOWNER: Flautt
Flautt
 (mailing address)
 WELL LOCATION:
 sec. 28 T 23 (N) R 1 E (W)
42 miles SW of Plendota
 (distance) (direction) (nearest town)

| description of formations encountered | from | to |
|---------------------------------------|-----------|------------|
| <u>Clay</u> | <u>0</u> | <u>10</u> |
| <u>Hard Sand</u> | <u>10</u> | <u>33</u> |
| <u>Sand</u> | <u>33</u> | <u>48</u> |
| <u>Sand & Gravel</u> | <u>48</u> | <u>106</u> |

WELL PURPOSE:
 (home, irrigation, municipal, industrial)

WELL COMPLETION DATA:
 (1) diameter (inches) 16
 (2) total depth (feet) 106
 (3) static water level (feet) 18 below above top of ground.
 (4) casing Steel 60,
 (material) (depth)
16 if telescope see back.
 (size)
 (5) screen 40
 (length) (depth to top)
16" Mild Steel
 (size) (material)
 (6) pump 60 1200
 (HP) (yield gpm)
Diesel
 (type power)
 (7) electric log No
 (yes or no)

(organization running log)
 (8) how well bottom plugged Plate


DRILLERS REMARKS:

DEPT. OF NATURAL RESOURCES
 BUREAU OF LAND & WATER RESOURCES

MAY 19 1982
RECEIVED

If well telescopes please sketch and show depths.

GROUND LEVEL

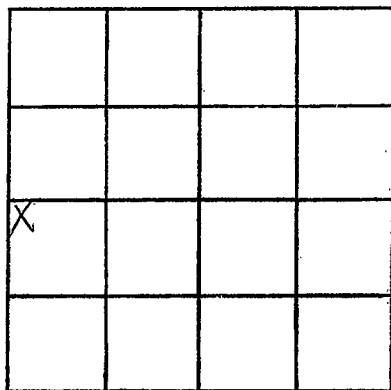

SECTION 28

Please indicate well location X.

ADDITIONAL INFORMATION

If more than one screen, show locations of each on sketch.