

MISSISSIPPI DEPARTMENT OF NATURAL RESOURCES
Bureau of Land and Water Resources
 Southport Mall
 P.O. Box 10631
 Jackson, Mississippi 39209
WATER WELL DRILLERS LOG

Jallahatchie
0 2016
MS-6W-01948

4-27 19 82 Nyer Well Jallahatchie
 date well completed firm name county well located

LANDOWNER:

Blount
Flaunt

(mailing address)

description of formations encountered

from

to

Clay	0	18
fine sand	18	29
sand	29	40
sand & gravel	40	110

WELL LOCATION:

sec. 28 T. 23 (N) R. 1 (E)
 S (W)
1 miles W of Glendale
 (distance) (direction) (nearest town)

WELL PURPOSE:

(home, irrigation, municipal, industrial)

WELL COMPLETION DATA:

- diameter (inches) 16
- total depth (feet) _____
- static water level (feet) 18 below/above top of ground.
- casing Steel, 70,
 (material) (depth)
16 if telescope see back.
 (size)
- screen 40,
 (length) (depth to top)
16, steel (mild)
 (size) (material)
- pump 60 1200
 (HP) (yield gpm)
liquid
 (type power)
- electric log No
 (yes or no)

(organization running log)

(8) how well bottom plugged plate


DRILLERS REMARKS:

DEPT. OF NATURAL RESOURCES
 BUREAU OF LAND & WATER RESOURCES

MAY 19 1982
RECEIVED

If well telescopes please sketch and show depths.

GROUND LEVEL

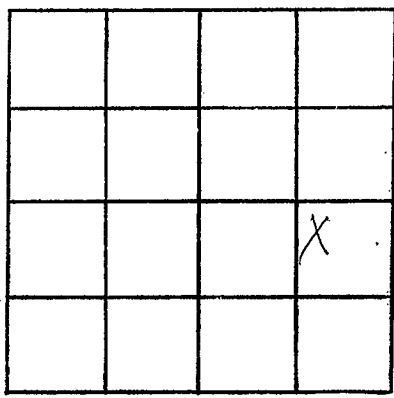

SECTION 28

Please indicate well location X.

ADDITIONAL INFORMATION

A series of horizontal lines for writing additional information, starting below the 'ADDITIONAL INFORMATION' header and extending to the bottom of the page.

If more than one screen, show locations of each on sketch.