

MISSISSIPPI DEPARTMENT OF NATURAL RESOURCES

Bureau of Land and Water Resources

Southport Mall

P.O. Box 10631

Jackson, Mississippi 39209

WATER WELL DRILLERS LOG

BUTANE GAS CO. OF GREENWOOD

POST OFFICE BOX 113E

GREENWOOD, MISS. 39095 county well located

Talabatche
 02017

3-25 1982 date well completed

Talabatche

| LANDOWNER: | description of formations encountered | from | to |
|-----------------------|---------------------------------------|-----------|------------|
| <i>Clifton Bishop</i> | <i>Clay</i> | <i>0</i> | <i>18</i> |
| | <i>fine sand mix clay</i> | <i>18</i> | <i>60</i> |
| | <i>gravel & sand & gravel</i> | <i>60</i> | <i>100</i> |

(mailing address)

WELL LOCATION:
 sec. 12 T 23 N R 18
4 miles NE of Glendora
 (distance) (direction) (nearest town)

WELL PURPOSE: irrigation
 (home, irrigation, municipal, industrial)

- WELL COMPLETION DATA:
- (1) diameter (inches) 16"
 - (2) total depth (feet) 100
 - (3) static water level (feet) 75 below above top of ground.
 - (4) casing Steel, 72'
 (material) (depth)
16" if telescope see back.
 (size)
 - (5) screen 28, 72
 (length) (depth to top)
16", steel
 (size) (material)
 - (6) pump 100 1500
 (HP) (yield gpm)
Diesel
 (type power)
 - (7) electric log NO
 (yes or no)
NO
 (organization running log)
 - (8) how well bottom plugged steel plate


DRILLERS REMARKS:
Charles R. Roper

DEPT. OF NATURAL RESOURCES
 BUREAU OF LAND & WATER RESOURCES

MAR 29 1982
 RECEIVED

If well telescopes please sketch and show depths.

GROUND LEVEL

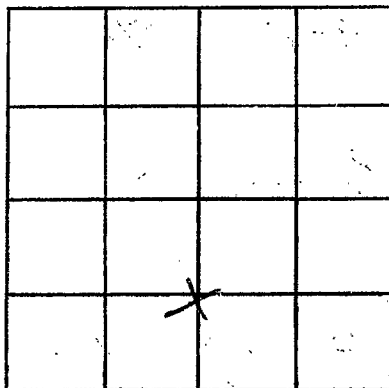

SECTION 12

Please indicate well location X.

ADDITIONAL INFORMATION

A series of horizontal lines for writing additional information.

If more than one screen, show locations of each on sketch.