

Tallahatchie
 CL-2115
 2019

MISSISSIPPI
 BOARD OF WATER COMMISSIONERS
 416 North State Street
 Jackson, Mississippi 39201

WATER WELL DRILLERS LOG

3-25 1982 LAYNE CENTRAL CO. TALLAHATCHIE
 date well completed firm name county well located

LANDOWNER:
 GREENWOOD IRRIGATION CO.
 @ RABBIT RIDGE PLANTATION
 TIPPO, MS
 (Crowe Farms)
 (mailing address)

WELL LOCATION: # 1067
 sec. 1 T. 23 N R. 1 W.
 miles Rabbit Ridge
 (distance) (direction) (nearest town)

WELL PURPOSE:
 (home, irrigation, municipal, industrial)

WELL COMPLETION DATA:

(1) diameter (inches) 32"
 (2) total depth (feet) 113'
 (3) static water level (feet) 10' below above top of ground.
 (4) casing steel 63'
 16" (material) (depth)
 (size) if telescope see back.
 (5) screen 50' 63'
 16" (length) (depth to top)
 (size) (material)
 200 2200
 (6) pump (HP) (yield gpm)
 gear drive
 (type power)
 (7) electric log no
 (yes or no)
 (organization running log)
 (8) how well bottom plugged st. plate

description of formations encountered	from	to
clay	0'	14
fine sand	14	35
med. coarse sand	35	47
coarse sand	47	68
c. sand & pea gravel	68	80
c. sand & gravel	80	96
c. sand & pea gravel	96	104
c. sand & gravel	104	113
clay	113	

DRILLERS REMARKS:


DEPT. OF NATURAL RESOURCES
 BUREAU OF LAND & WATER RESOURCES

JUN 24 1982

RECEIVED

If well telescopes please sketch and show depths.

GROUND LEVEL

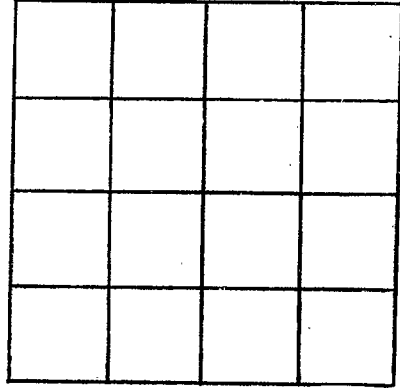

SECTION _____

Please indicate well location X.

ADDITIONAL INFORMATION

If more than one screen,
show locations of each on sketch.