

CL-2115
 2020

MISSISSIPPI
 BOARD OF WATER COMMISSIONERS
 416 North State Street
 Jackson, Mississippi 39201

WATER WELL DRILLERS LOG

3-25 19 82 LAYNE CENTRAL CO. TALLAHATCHIE
 date well completed firm name county well located

LANDOWNER:
 GREENWOOD IRRIGATION
 @ RABBIT RIDGE PLANTATION
 TIPPO, MS
 (Crowe Farm)
 (mailing address)

description of fomations encountered	from	to
clay	0	15
coarse brown sand	15	26
coarse sand - med	26	43
c. sand	43	76
c. sand & gravel	76	92

WELL LOCATION: # 2 of 7
 sec. 1 T. 23 N R. 1 W
 miles of Rabbit Ridge
 (distance) (direction) (nearest town)

WELL PURPOSE:
 (home, irrigation, municipal, industrial)

WELL COMPLETION DATA:

(1) diameter (inches) 32"

(2) total depth (feet) 92'

(3) static water level (feet) 9' 10" below top of ground.

(4) casing steel 52' (material), (depth) 16" if telescope see back. (size) 40' 52'

(5) screen 16" (length), (depth to top) st. steel (material)

(6) pump 40 (HP), 650 (yield gpm) gear drive (type power)

(7) electric log no (yes or no) (organization running log)


(8) how well bottom plugged st. plate

DEPT. OF NATURAL RESOURCES
 BUREAU OF LAND & WATER RESOURCES
 JUN 24 1982
 RECEIVED

DRILLERS REMARKS:

If well telescopes please sketch and show depths.

GROUND LEVEL

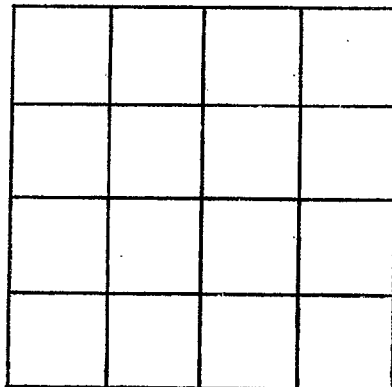

SECTION _____

Please indicate well location X.

ADDITIONAL INFORMATION

Lined area for additional information.

If more than one screen, show locations of each on sketch.