

MISSISSIPPI DEPARTMENT OF NATURAL RESOURCES

Bureau of Land and Water Resources

Southport Mall

P.O. Box 10631

Jackson, Mississippi 39209

WATER WELL DRILLERS LOG

Tallahatchie
W
Ø 2022

date well completed

1983

firm name

Dyer Well + Smig

county well located

Tallahatchie

LANDOWNER:

Ralph Frank

description of formations encountered

from

to

(mailing address)

WELL LOCATION:

sec. B T 23 (N) R. 1 E (W)
3 miles NW of Glendon
 (distance) (direction) (nearest town)

WELL PURPOSE:

(home, irrigation, municipal, industrial)

WELL COMPLETION DATA:

- (1) diameter (inches) 16"
- (2) total depth (feet) 96
- (3) static water level (feet) 16 below above top of ground.
- (4) casing steel 56,
 (material) (depth)
 (size) if telescope see back.
- (5) screen 40' 40'
 (length) (depth to top)
16" steel
 (size) (material)
- (6) pump 100 1300
 (HP) (yield gpm)
diesel
 (type power)
- (7) electric log no
 (yes or no)
no
 (organization running log)
- (8) how well bottom plugged plate

Clay 0 24
Fine Sand 24 38
Sand 38 65
Sand + Gravel 65 96

DEPT. OF NATURAL RESOURCES
 BUREAU OF LAND & WATER RESOURCES


FEB - 3 1983

RECEIVED

DRILLERS REMARKS:

If well telescopes please sketch and show depths.

GROUND LEVEL

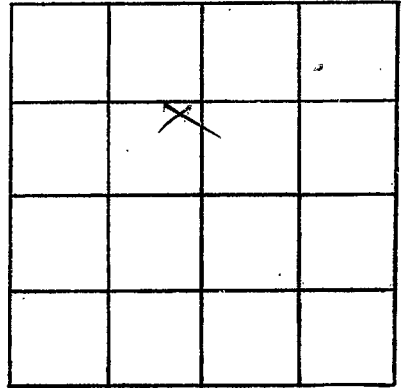

SECTION 18

Please indicate well location X.

ADDITIONAL INFORMATION

If more than one screen,
show locations of each on sketch.