

MISSISSIPPI DEPARTMENT OF NATURAL RESOURCES

Bureau of Land and Water Resources

Southport Mall

P.O. Box 10631

Jackson, Mississippi 39209

WATER WELL DRILLERS LOG

BUTANE GAS COMPANY

OF GREENWOOD

Tallahatchie

*Tallahatchie*  
 2023

MS-GW-02009

1-19 1983  
 date well completed

firm name

county well located

LANDOWNER:

*Sybil Sturdivant*

*Webb Mo.*

(mailing address)

description of formations encountered

from

to

*Clay*

0 10

*sand*

10 35

*SAND + GRAVEL*

35 93

WELL LOCATION:

sec. 6 T. 23 N. R. 1 E. W  
 3.5 miles SE of Webb  
 (distance) (direction) (nearest town)

WELL PURPOSE: IRRIGATION  
 (home, irrigation, municipal, industrial)

WELL COMPLETION DATA:

- (1) diameter (inches) 16"
- (2) total depth (feet) 93
- (3) static water level (feet) 10 below top of ground.
- (4) casing Steel, 53 (material), (depth), 16" (size) if telescope see back.
- (5) screen 40 (length), 53 (depth to top), 16 (size), Steel (material)
- (6) pump 30 (HP), 1100 (yield gpm), Diene (type power)
- (7) electric log NO (yes or no), NO (organization running log)
- (8) how well bottom plugged Steel plate

DEPT. OF NATURAL RESOURCES  
 BUREAU OF LAND & WATER RESOURCES

FEB 18 1983


RECEIVED

DRILLERS REMARKS:

*Charles Ramon*

If well telescopes please sketch and show depths.

GROUND LEVEL

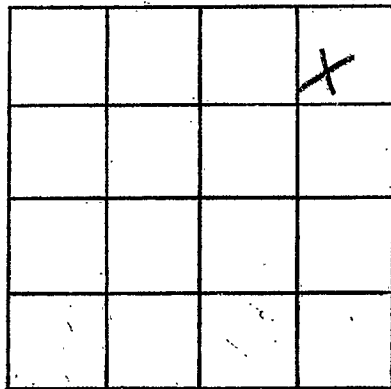

SECTION 6

Please indicate well location X.

ADDITIONAL INFORMATION

If more than one screen,  
show locations of each on sketch.