

TALLA. MISSISSIPPI BOARD OF WATER COMMISSIONERS

9300
Tallahassee
Cotton
D. H. H.

P25 P21
7-18-60

WATER WELL DRILLERS LOG

Date: 7/10, 1960, Driller: Fine County, Fine County
(Name)

| (1) Owner of Land: | Description & Color of Materials Sand, Clay, Red Clay, Shell, etc. | Thick- ness Feet | Depth Feet |
|---|---|------------------------|---------------|
| 1610 Canton (Name) clock tower, miss (Address) | Silty clay Sand Coarse Sand & fine gravel | 18 32 | 18 50 |
| (2) Location: 1/4, 1/4, Sec. 8 T23R1E 10 miles east of Mendon (distance) (direction) (Nearest Town) | | 39 | 89 |
| (3) Topography: Level (Hilly) (Flat) (Level) | | | |
| (4) Purpose of Well: Irrigation (Domestic Irrigation Municipal, Industrial, Other) | | | |

CODED.

CODED

Information upon completion of well:

(1) Diameter 16 inches.

(2) Total Depth 89 feet.

(3) Water Level 25 feet below top of ground.


(4) Cased to 54, Size 16

(5) Screen: Size 12, Length 35

(6) Were any formations sealed against pollution?
 _____ yes, _____ no.

If YES depth of formation _____
 Why _____

Drillers Remarks: Pumping
 3000 g.p.m.

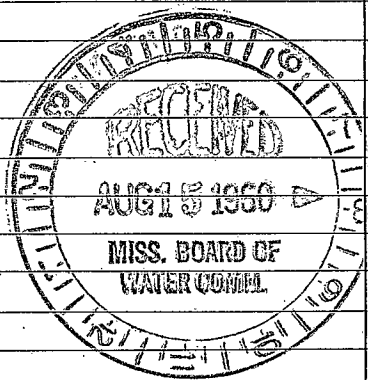

Well No.

(Use Back Side)

