

Tallahatchie

P24
6-11-65

MISSISSIPPI BOARD OF WATER COMMISSIONERS

James R. Lipe
WATER WELL DRILLERS LOG

CODED

Date: 6-11, 1965, Driller: James R. Lipe County: Tallahatchie
(Name)

(1) Owner of Land: A.A. Mabus
(Name)
Mace, Miss
(Address)

(2) Location: 1/4, 1/4, Sec. 35 T. 23 N. R. 1 E.
1/2 miles South of Mace
(distance) (direction) (Nearest Town)

(3) Topography: level
(Hilly) (Flat) (Level)

(4) Purpose of Well: Domestic
(Domestic Irrigation, Municipal, Industrial, Other)

Description & Color of Materials Sand, Clay, Red Clay, Shell, etc.	Thick- ness Feet	Depth Feet
Clay and Sand	0	20
gray Sand	20	40
" "	40	60
" "	60	80
Sand and gravel	80	100
Clay and sand	100	120
gray Sand	120	140
Sand and Clay	140	160
" "	160	180
" "	180	200
" "	200	220
Shell and Clay	220	240
" "	240	260
Clay and Rocks	260	280
" "	280	300
Clay	300	320
" "	320	340
" "	340	360
sand and Clay	360	380
" "	380	400
Clay	400	420
Sand	420	440
" "	440	460
Clay	460	480
Sand and Clay	480	500
" "	500	520
Good Sand	520	540
Clay	540	560
Clay	560	580
sand	580	600
Good Sand	600	620

Information upon completion of well:

(1) Diameter 2 inches.

(2) Total Depth 623 feet.

(3) Water Level 0 feet below top of ground.

(4) Cased to 603, Size 2

(5) Screen: Size 2, Length 20


(6) Were any formations sealed against pollution?
_____ yes, _____ no.

If YES depth of formation _____

Why _____

Drillers Remarks: Hit Rock

210' 6" thick

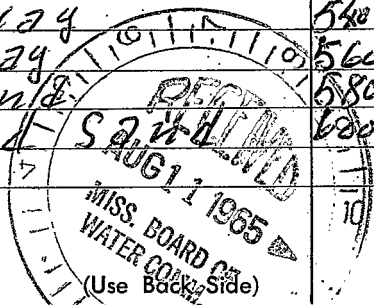

Well No. 10

