

CODED

Tallahatchie  
P 27  
10-10-69

MISSISSIPPI  
BOARD OF WATER COMMISSIONERS  
416 North State Street  
Jackson, Mississippi 39201

WATER WELL DRILLERS LOG  
BUTANE GAS CO. OF GREENWOOD

Oct. 10 1969 date well completed  
GREENWOOD, MISSISSIPPI firm name  
Tallahatchie county well located

LANDOWNER:  
Blue Channel Enterprise  
Tippo, Miss.  
(mailing address)

description of formations encountered	from	to
CLAY	0	15
SAND + GRAVEL	15	101

WELL LOCATION:  
sec. 9 T. 23 N R. 1 E  
5 5  
2 miles S of Tippo  
(distance) (direction) (nearest town)

WELL PURPOSE: IRRIGATION  
(home, irrigation, municipal, industrial)

- WELL COMPLETION DATA:
- (1) diameter (inches) 16
  - (2) total depth (feet) 101
  - (3) static water level (feet) 7 below top of ground.
  - (4) casing Steel, 61 (material), (depth)  
16 (size) if telescope see back.
  - (5) screen 40, 61 (length), (depth to top)  
16 (size), Steel (material)
  - (6) pump 48, 2,000 (HP), (yield gpm)  
Diesel (type power)
  - (7) electric log NO (yes or no)
  - (organization running log)
  - (8) how well bottom plugged Steel Plate


DRILLERS REMARKS:

OCT 15 1969

MISS. BD. OF  
WATER COMM.

If well telescopes please sketch and show depths.

GROUND LEVEL

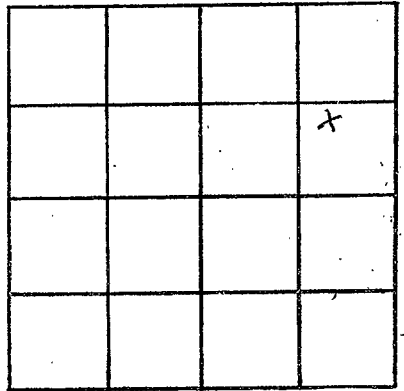

SECTION 9

Please indicate well location X.

ADDITIONAL INFORMATION

If more than one screen,  
show locations of each on sketch.