

CODED

Tallahatchie
P 30
10-10-69

MISSISSIPPI
BOARD OF WATER COMMISSIONERS
416 North State Street
Jackson, Mississippi 39201

WATER WELL DRILLERS LOG
BUTANE GAS CO. OF GREENWOOD

Oct. 10 1969 date well completed
GREENWOOD, MISSISSIPPI firm name
Tallahatchie county well located

LANDOWNER:

Blue Channel Enterprise
Tippo, Miss.
(mailing address)

description of formations encountered

from to

Clay 0 15
SAND & GRAVEL 15 94

WELL LOCATION:

sec. 16 T 23 N R 1 E
S W
3 1/2 miles S of Tippo
(distance) (direction) (nearest town)

WELL PURPOSE: Irrigation
(home, irrigation, municipal, industrial)

WELL COMPLETION DATA:

- (1) diameter (inches) 16
- (2) total depth (feet) 94
- (3) static water level (feet) 7 below above top of ground.
- (4) casing steel, 54 (material) (depth)
16 (size) If telescope see back.
- (5) screen 40, 54 (length) (depth to top)
16 (size) steel (material)
- (6) pump 48, 2000 (HP) (yield gpm)
Diesel (type power)
- (7) electric log NO (yes or no)

(organization running log)

(8) how well bottom plugged
Steel plate


DRILLERS REMARKS:

OCT 15 1969

MISS. BD. OF
WATER COMM

If well telescopes please sketch and show depths.

GROUND LEVEL

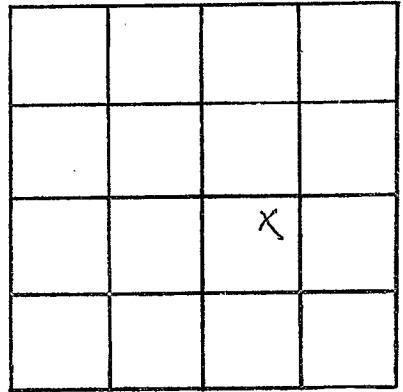

SECTION 16

Please indicate well location X.

ADDITIONAL INFORMATION

If more than one screen,
show locations of each on sketch.