

TALLAHATCHIE
P 33
8-19-74

MISSISSIPPI
BOARD OF WATER COMMISSIONERS CODED
416 North State Street
Jackson, Mississippi 39201

WATER WELL DRILLERS LOG

EUTANE GAS CO. OF GREENWOOD TALLAHATCHIE

8/14/74 date well completed
firm name
county well located

LANDOWNER:
James Allison
Tippo, Miss.
(mailing address)

description of formations encountered	from	to
Clay	20	20
Sand	20	60
Sand + Gravel	60	140
Clay	140	200
Shale	200	260
Sand + Shale	260	600
Coarse Sand	600	639

WELL LOCATION:
sec. 23 T 23 N R 1 E S 8
2 miles N of Maccl
(distance) (direction) (nearest town)

WELL PURPOSE: Home
(home, irrigation, municipal, industrial)

WELL COMPLETION DATA:
(1) diameter (inches) 4 1/2
(2) total depth (feet) 639
(3) static water level (feet) 20 below above top of ground.
(4) casing Steel 609 (material) (depth)
4 1/2 (size) If telescope see back.
(5) screen 30 609 (length) (depth to top)
2" Stairless (size) (material)
(6) pump 1 20 (HP) (yield gpm)
Elec. (type power)
(7) electric log No (yes or no)
(organization running log)

(8) how well bottom plugged
Lead Plug

DRILLERS REMARKS:

RECEIVED
SEP - 9 1974


If well telescopes please sketch and show depths.

GROUND LEVEL

105' - 4" CASING →

50' - 2" CASING →

30' - 2" SCREEN →

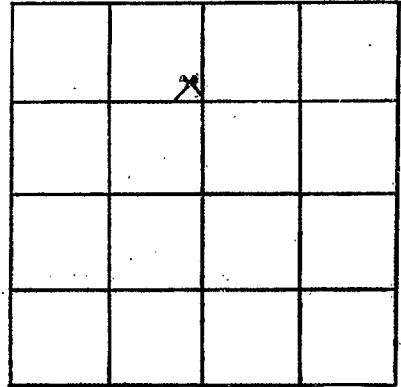

SECTION 23

Please indicate well location X.

ADDITIONAL INFORMATION

If more than one screen, show locations of each on sketch.