

Tallahatchie

P. 34

8-21-74

MISSISSIPPI BOARD OF WATER COMMISSIONERS
416 North State Street
Jackson, Mississippi 39201

CODED

WATER WELL DRILLERS LOG

8-21 1974
date well completed

24 Pipe Well Co
firm name

Tallahatchie
county well located


LANDOWNER:	description of formations encountered	from	to
George Jennings	Top soil	0	90
Tippo Miss.	Sand	90	140
(mailing address)	"	140	180
WELL LOCATION:	Sand and clay	120	140
sec. 11 T. 23 N. R. 1 E	" " "	140	160
3 miles South of Tippo	clay	160	180
(distance) (direction) (nearest town)	"	180	200
WELL PURPOSE:	Sand	200	220
(home) irrigation, municipal, industrial	clay	220	240
WELL COMPLETION DATA:	"	240	260
(1) diameter (inches) 4 x 2	"	260	280
(2) total depth (feet) 671	Sand and clay	280	300
(3) static water level (feet) flowing below top of ground.	" "	300	320
(4) casing Steel, 651 (depth)	clay	320	340
4 x 2 (size) If telescope see back.	"	340	360
(5) screen 20 (length), 651 (depth to top)	"	360	380
2 (size), S.S. (material)	"	380	400
(6) pump 1 (HP), 20 (yield gpm)	"	400	420
elec. (type power)	Sand	420	440
(7) electric log no (yes or no)	"	440	460
no (organization running log)	clay	460	480
(8) how well bottom plugged Steel cap	"	480	500
DRILLERS REMARKS:	Sand	500	520
	Good Sand	520	540
		540	560
		560	580
		580	600
		600	671

REGISTERED
SEP - 5 1974

MISS. BD. OF WATER COMMISSIONERS

If well telescopes please sketch and show depths.

GROUND LEVEL

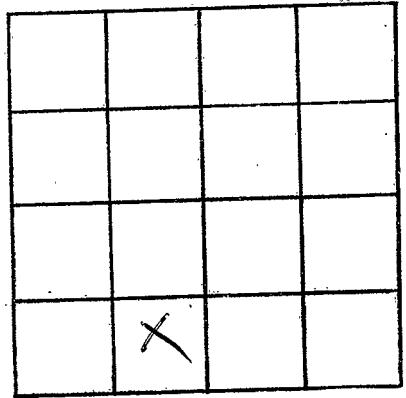

SECTION 11

Please indicate well location X.

ADDITIONAL INFORMATION

If more than one screen,
show locations of each on sketch.