

Tallahatchie
P 36
6-5-75

MISSISSIPPI
BOARD OF WATER COMMISSIONERS
416 North State Street
Jackson, Mississippi 39201

CODED

WATER WELL DRILLERS LOG

6-5-75 19 BUTANE GAS CO. OF GREENWOOD Tallahatchie
date well completed firm name county well located

LANDOWNER:	description of formations encountered	from	to
Mike Mills SWAN LAKE (mailing address)			
WELL LOCATION: sec. 5 T 24 N R 1 E 15F 3 1/2 miles SW of TIPPO (distance) (direction) (nearest town)			
WELL PURPOSE: FRR (home, irrigation, municipal, industrial)			
WELL COMPLETION DATA: (1) diameter (inches) 16 (2) total depth (feet) 103 (3) static water level (feet) 16 below top of ground. (4) casing Steel 63 (material) (depth) 16" (size) if telescope see back. (5) screen 40' 63 (length) (depth to top) 16" Steel (size) (material) (6) pump 60 2500 (HP) (yield gpm) Diesel (type power) (7) electric log No (yes or no) (organization running log) (8) how well bottom plugged Steel Plate			
DRILLERS REMARKS:			


CODED

REGISTERED
JUN 16 1975

MISS. BD. OF WATER COMMISSIONERS

If well telescopes please sketch and show depths.

GROUND LEVEL

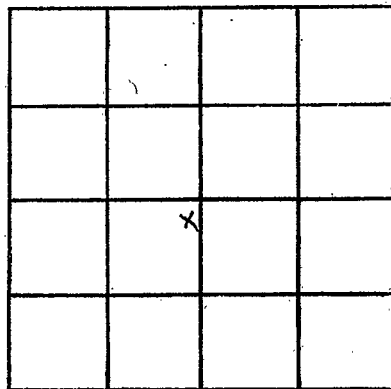

SECTION 5

Please indicate well location X.

ADDITIONAL INFORMATION

If more than one screen, show locations of each on sketch.