

Tallahatchie
P 37
7-3-75

MISSISSIPPI
BOARD OF WATER COMMISSIONERS
416 North State Street
Jackson, Mississippi 39201

CODED

WATER WELL DRILLERS LOG

Singer-Rayne
J. W. Fennell

Tallahatchie

July 3 1975
date well completed

firm name

county well located

LANDOWNER: J. W. Fennell Phillips, Miss.	description of formations encountered	from	to
(mailing address)			
WELL LOCATION: sec. 35 T 25 N R 1 E 15F	Fine Sand	19	30'
6 miles Northeast Phillip (distance) (direction) (nearest town)	Coarse Sand	30	65'
WELL PURPOSE: irrigation (home, irrigation, municipal, industrial)	Coarse Sand & Gravel	65	91'
WELL COMPLETION DATA:			
(1) diameter (inches) 16"			
(2) total depth (feet) 91'			
(3) static water level (feet) 9 below top of ground. above			
(4) casing Steel, 41' (material) (depth) 16" if telescope see back. (size)			
(5) screen 50', 50' 41' (length) (depth to top)			
16" Steel (size) (material)			
(6) pump 60 2500-3000 (HP) (yield gpm) engine (type power)			
(7) electric log no (yes or no)			
(organization running log)			
(8) how well bottom plugged steel plate			
DRILLERS REMARKS:			


CODED

DECLASSIFIED

MAY 5 1975

If well telescopes please sketch and show depths.

GROUND LEVEL

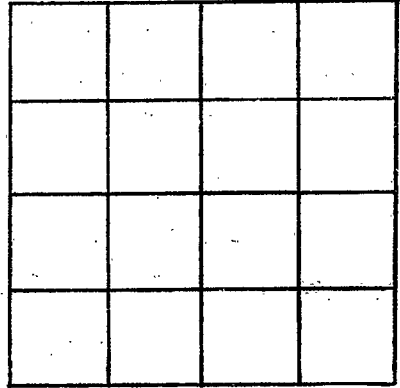

SECTION _____

Please indicate well location X.

ADDITIONAL INFORMATION

If more than one screen, show locations of each on sketch.