

Tallahatchie
 P38
 1-67

MISSISSIPPI
 BOARD OF WATER COMMISSIONERS
 416 North State Street
 Jackson, Mississippi 39201

CODED

WATER WELL DRILLERS LOG

1/27 date well completed
 1967 Delta Well Supply Co. firm name
 Tallahatchie county well located

LANDOWNER:
 W. S. Caldwell
 Philipps Miss.
 (mailing address)

WELL LOCATION:
 sec. 34 T23 N R 1 E
 5 1/2 miles N.E. East of Philipps
 (distance) (direction) (nearest town)


WELL PURPOSE: Home
 (home, irrigation, municipal, industrial)

WELL COMPLETION DATA:

- (1) diameter (inches) 3x2
- (2) total depth (feet) 671
- (3) static water level (feet) Flow below top of ground.
- (4) casing 651 (material) (depth)
3x2 (size) if telescope see back.
- (5) screen 20ft, 651' (length) (depth to top)
2", SS (size) (material)
- (6) pump 20 (HP) (yield gpm)
 (type power)
- (7) electric log No (yes or no)
 (organization running log)
- (8) how well bottom plugged BPV

description of formations encountered	from	to
	0	20
Fine sand	20	30
Sand & gravel	30	110
Block	110	112
Clay	112	248
Rock	248	250
Clay	250	255
Rock	255	256
Clay	256	259
Rock	259	260
Clay	260	280
Block	280	281
Clay	281	308
Rock	308	310
Clay	310	320
Rock	320	321
shale	321	326
Rock	326	327
shale	327	367
Rock	367	368
Clay	368	385
Fine sand & gravel	385	450
Clay	450	605
Sand & Mud	605	680

CODED

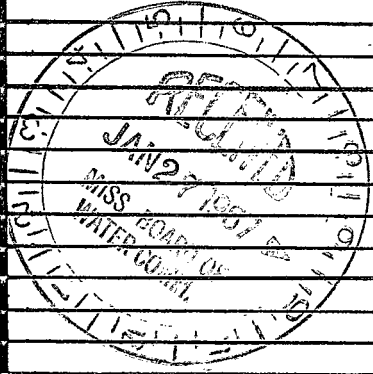

DRILLERS REMARKS:

