

CODED

MISSISSIPPI
BOARD OF WATER COMMISSIONERS
416 North State Street
Jackson, Mississippi 39201

WATER WELL DRILLERS LOG

TALAHATCHIE
P 41
4-16-75

April 16, 1975 Dyer-Sullivan, Inc. Talahatchie
date well completed firm name county well located


LANDOWNER: P.L. Bbke #1
P.O. Box 580
Greenwood, Miss.
(mailing address)

description of formations encountered	from to	
Clay	0	27
Fine SAND	27	75
SAND + GRAVEL	75	115

WELL LOCATION:
sec 2 T 23 N R 1 E 15F
2 miles SW of Tippo
(distance) (direction) (nearest town)

WELL PURPOSE: Irrigation
(home, irrigation, municipal, industrial)


- WELL COMPLETION DATA:
- (1) diameter (inches) 16"
 - (2) total depth (feet) 115'
 - (3) static water level (feet) 13' below above top of ground.
 - (4) casing BK Iron, 75',
(material) (depth)
16" if telescope see back.
(size)
 - (5) screen 40', 75'
(length) (depth to top)
16", BK Invert
(size) (material)
 - (6) pump 60 3000
(HP) (yield gpm)
Diesel
(type power)
 - (7) electric log No
(yes or no)
 - (organization running log)
 - (8) how well bottom plugged Plate

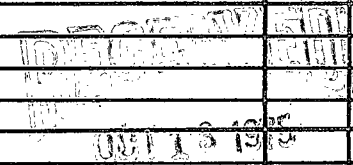

DRILLERS REMARKS:

If well telescopes please sketch and show depths.

GROUND LEVEL

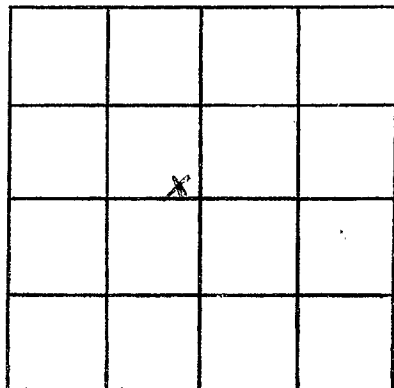

SECTION 2

Please indicate well location X.

ADDITIONAL INFORMATION

If more than one screen, show locations of each on sketch.