

Tallahatchie
 P-45
 02-20-80

MISSISSIPPI
 BOARD OF WATER COMMISSIONERS
 416 North State Street
 Jackson, Mississippi 39201

CODED

WATER WELL DRILLERS LOG
 BUTANE GAS COMPANY
 OF CANTONWOOD

Tallahatchie
 county well located

2-20-80
 date well completed

LANDOWNER:	description of formations encountered	from	to
Blue Channel Enterprises			
Tippie's (mailing address)	Clay	0	25
	Sand	25	40
	Sand + Gravel	40	105
WELL LOCATION:			
sec 16 T 23 N R 1 E S W 4 1/2 miles SW of Tippie (distance) (direction) (nearest town)			
WELL PURPOSE: CAT FISH (home, irrigation, municipal, industrial)			
WELL COMPLETION DATA:			
(1) diameter (inches) 16"			
(2) total depth (feet) 105			
(3) static water level (feet) 15 below top of ground.			
(4) casing Steel, 65' (material) (depth) 16" If telescope see back. (size)			
(5) screen 40, 65' (length) (depth to top) 16" Steel (size) (material)			
(6) pump 60, 2000 (HP) (yield gpm) Elec. (type power)			
(7) electric log NO (yes or no) (organization running log)			
(8) how well bottom plugged Steel P.H.T. 2			
DRILLERS REMARKS:			

CODED


DEPT. OF NATURAL RESOURCES
 BUREAU OF LAND & WATER RESOURCES

FEB 25 1980

RECEIVED

If well telescopes please sketch and show depths.

GROUND LEVEL

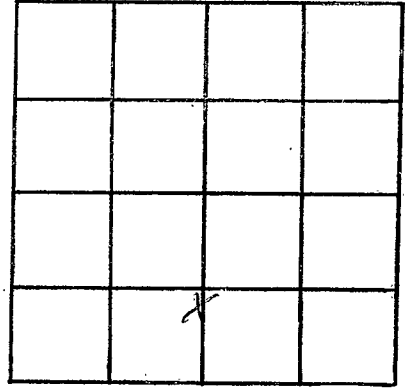

SECTION 16

Please indicate well location X:

ADDITIONAL INFORMATION

If more than one screen, show locations of each on sketch.