

MISSISSIPPI DEPARTMENT OF NATURAL RESOURCES

Bureau of Land and Water Resources

Southport Mall

P.O. Box 10631

Jackson, Mississippi 39209

WATER WELL DRILLERS LOG

TALLAHATCHIE
 49
 1-27-84

749

BUTANE GAS COMPANY

CODED

Tallahatchie
 county well located

1-27
 date well completed

1984
 OF GREENWOOD

LANDOWNER:
 Bishop - Stoddard
 Farms
 (mailing address)

description of formations encountered	from	to
CLAY	0	40
SAND & gravel	40	105

WELL LOCATION:
 sec. 31 T. 23 N. R. 10 E
 S W
 4 miles E of Glendora
 (distance) (direction) (nearest town)

CODED

WELL PURPOSE: Irrigation
 (home, irrigation, municipal, industrial)

- WELL COMPLETION DATA:
- (1) diameter (inches) 12"
 - (2) total depth (feet) 105
 - (3) static water level (feet) 30 ^(below) above top of ground.
 - (4) casing Steel (material), 65 (depth)
 12" (size) if telescope see back.
 - (5) screen 40' (length), 65 (depth to top)
 12" (size), Steel (material)
 - (6) pump 80 (HP), 700 (yield gpm)
Diode (type power)
 - (7) electric log No (yes or no)
No (organization running log)
 - (8) how well bottom plugged Steel plate

DRILLERS REMARKS:
 Carlos Ramos


DEPT. OF NATURAL RESOURCES
 BUREAU OF LAND & WATER RESOURCES

FEB 21 1984

RECEIVED

If well telescopes please sketch and show depths.

GROUND LEVEL

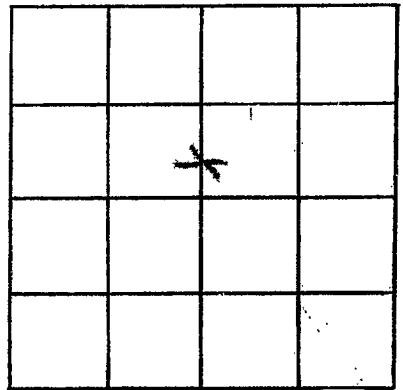

SECTION 31

Please indicate well location X.

ADDITIONAL INFORMATION

If more than one screen,
show locations of each on sketch.