

MISSISSIPPI DEPARTMENT OF NATURAL RESOURCES

Bureau of Land and Water Resources

Southport Mall

P.O. Box 10631

Jackson, Mississippi 39209

WATER WELL DRILLERS LOG

CODED

Tallahatchie
P50
7/9/84

BUTANE GAS COMPANY

Tallahatchie
county well located

7-9
date well completed

19

84

OF GREENWOOD

LANDOWNER:
J. W. Fennell
Phillip M.
(mailing address)

description of formations encountered	from	to
CLAY	0	18
Fine SAND	18	45
SAND and gravel	45	93

WELL LOCATION:
sec. 12 T. 23 N. R. 1 E.
3.5 miles S.E. of TIPPO
(distance) (direction) (nearest town)

WELL PURPOSE:
(home, irrigation, municipal, industrial)

- WELL COMPLETION DATA:
- (1) diameter (inches) 16"
 - (2) total depth (feet) 93
 - (3) static water level (feet) 21 ^{below} _{above} top of ground.
 - (4) casing Steel, 53'
(material) (depth)
16"
(size) if telescope see back.
 - (5) screen 40', 53'
(length) (depth to top)
16", Steel
(size) (material)
 - (6) pump 60 2000
(HP) (yield gpm)
Quail
(type power)
 - (7) electric log No
(yes or no)
No
(organization running log)
 - (8) how well bottom plugged steel plate

CODED

DEPT. OF NATURAL RESOURCES
BUREAU OF LAND & WATER RESOURCES


AUG 6 1984

RECEIVED

DRILLERS REMARKS:
Richard Vest

If well telescopes please sketch and show depths.

GROUND LEVEL

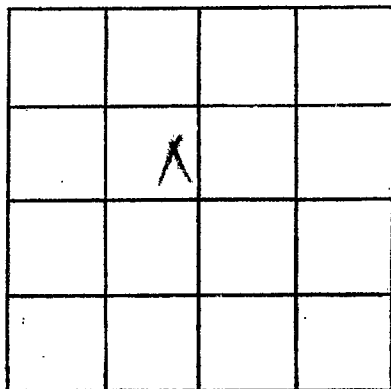

SECTION 12

Please indicate well location X.

ADDITIONAL INFORMATION

If more than one screen,
show locations of each on sketch.