

MISSISSIPPI DEPARTMENT OF NATURAL RESOURCES

Bureau of Land and Water Resources

Southport Mall

P.O. Box 10631

Jackson, Mississippi 39209

WATER WELL DRILLERS LOG

CODED

TALLAHATCHIE
P 51

3-26

1987 J & K Irrigation

Tallahatchie

date well completed

firm name

county well located

LANDOWNER: H.C. Strider  
Phillip, Miss  
 (mailing address)

description of formations encountered

from to

<del>CLAY</del>	0	19
FINE SAND	19	31
COURSE SAND & GRAVEL	31	88

WELL LOCATION:

sec. 21 T. 23 N. R. 1 E  
6 miles SE of TIPPO  
 (distance) (direction) (nearest town)

WELL PURPOSE: IRRIGATION  
 (home, irrigation, municipal, industrial)

WELL COMPLETION DATA:

- (1) diameter (inches) 16"
- (2) total depth (feet) 88'
- (3) static water level (feet) 3 below above top of ground.
- (4) casing Steel, 48'  
 (material) (depth)  
16" if telescope see back.  
 (size)
- (5) screen 40', 48'  
 (length) (depth to top)  
16", Steel  
 (size) (material)
- (6) pump 60 2800  
 (HP) (yield gpm)  
Diesel  
 (type power)
- (7) electric log NO  
 (yes or no)

(organization running log)

(8) how well bottom plugged plato

DRILLERS REMARKS:

CODED


RECEIVED

JUN 30 1987

Department of Natural Resources  
 Bureau of Land & Water Resources

If well telescopes please sketch and show depths.

GROUND LEVEL

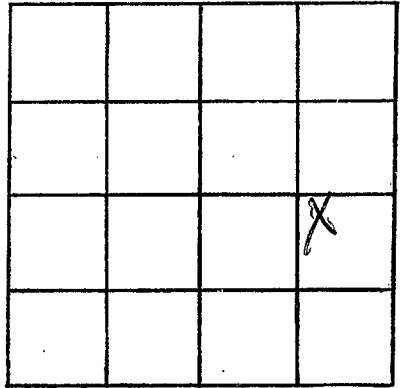

SECTION 21

Please indicate well location X.

ADDITIONAL INFORMATION

If more than one screen,  
show locations of each on sketch.