

County: Tallahatchie
 Permit #: GW-44589
 Irrigation Equipment
 Driller:
 Date drilling completed: 11-8-10

State Well Report
Part 1 - Driller's Log
 Mississippi Department of Environmental Quality
 Office of Land and Water Resources
 P.O. Box 2309
 Jackson, MS 39225
 (601)961-5210
 (601)961-5228 (fax)

For Office Use Only:
 Aquifer: P 67
 Well #: _____
 L. S. Elevation: _____
 E-log #: _____

State Law requires that this report be prepared by the license holder responsible for the work and filed with the Department at the above address within 30 days of completion of drilling of the well or borehole.

<p>Information on Well Owner (Landowner if borehole is not for a water well)</p> <p>Owner Name: <u>Charles L. Davis</u> Mailing Address: <u>188 Leverette Lane</u> <u>Cascilla Ms. 38920</u> City State Zip Code Telephone No. () _____</p>	<p>Well or Borehole Location</p> <p>Latitude: <u>33-53-17.5</u> Longitude: <u>90-09-41.5</u> Method of Lat/Long (circle one): Conventional Survey, USGS quad, <u>(Hand-held GPS)</u> Survey-grade GPS <u>NW 1/4 SE 1/4 Sec 2</u> Twn <u>23N</u> Rng <u>1E</u> Distance Direction Nearest Town <u>2</u> Miles <u>SE</u> of <u>Tippo</u></p>
--	--

Well / Borehole Data

Date drilling started: 11-8-10 Date drilling completed: 11-8-10 Hole depth: 121 Hole diameter: 18"
 Location of the source of any surface water used for drilling: Surface Water
 Method of dosing and volume of Chlorine used in drilling and development: 50 PPM
 Logs run (circle all applicable) (No log run) Electric Gamma Ray Density Sonic Neutron Other: _____
 Name of organization running log(s): _____
 Purpose of borehole (check one): Water Well Geotechnical/Geological Investigation _____ Ground Source Heat Pump _____
 Seismic Survey _____ Other (describe) _____
If drilling is not related to water well construction, skip the remainder of this block
 Purpose of Well (check one): Home _____ Industrial _____ Public Supply _____ Irrigation Fish Culture _____ Other: _____
 If a flowing well, method of flow regulation: Valve _____ Other (describe) _____
 Static Water Level: 115 feet above or (below) (circle one) land surface Date measured: 11-9-10
 Method of Measurement (circle one) (steel tape) electric tape air line other: _____
 Well depth: 121 Well grouted to a depth of 10 feet Type of grout (circle one): Neat Cement (Bentonite) Mix
 Casing length: 81 feet Casing diameter: 10 inches Type of casing: PVC
 Screen length: 40 feet Screen diameter: 10 inches Type of screen: PVC
 Screen slot size: .050 inches Setting depth: From 82 feet to 121 feet
 Type of completion (circle all applicable): (Gravel packed) Underreamed Telescoped Open hole Natural Development
 Other (describe): _____
 Top of lap pipe or reduction in casing: _____ feet. *If telescoped or more than one screen, describe on next page*

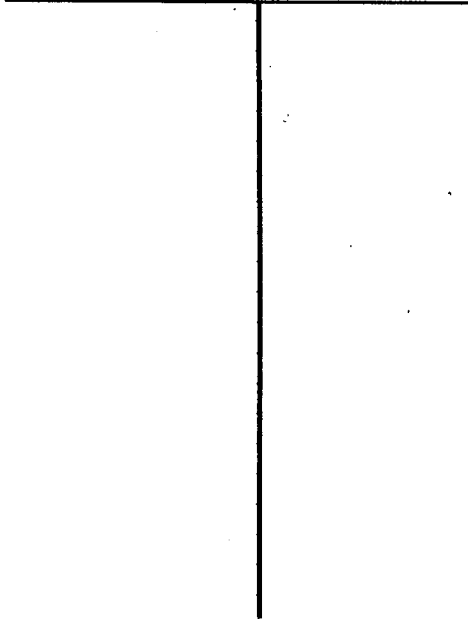
Form: OLWR-SWR-1A (04/08)

RECEIVED
 NOV 23 2010
 BY: OLWR

P67

The sketch below only required for water wells

If well telescopes, show depths on sketch

Ground Level → 

Description of formations encountered must be provided for all wells and boreholes, unless specifically exempted by regulations

Description of Formations Encountered	From (depth)	To (depth)
Clay	Ground Level	21
Fine Sand	22	29
Fine Sand + Gravel	30	40
Medium Sand + Gravel	41	121

If more than one screen, show location of each on sketch

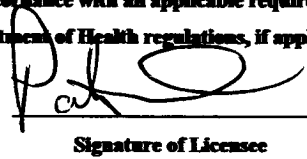
Sketch the property layout and include the following: 1) the well location; 2) any permanent structures on the property that may aid in locating the well; 3) any roads, power lines, or other items that may aid in locating the property and the well; 4) a north arrow.

Landowner Name: Charles Davis

Form: OLWR-SWR-1A (04/08)

I certify that the well/borehole was drilled, constructed, and completed in accordance with all applicable requirements of the Mississippi Department of Environmental Quality and the Mississippi Department of Health regulations, if applicable, and state laws.

Patrick M Chism 0695 _____
Print Name of Responsible Licensee and License No. Date


Signature of Licensee

RECEIVED
NOV 23 2010
BY: OLWR

County: Tallahatchie
 Permit #: GW-44589
 Irrigation Equipment
 Driller:
 Date completed: 11-8-10
 Copy information from block on Part 1

STATE WELL REPORT

Part 2

Pump Installer's Completion Report
 Mississippi Department of Environmental Quality
 Office of Land and Water Resources
 P.O. Box 2309
 Jackson, MS 39225
 (601)961-5210
 (601)961-5228 (fax)

For Office Use Only:
 Aquifer: _____
 Well #: _____
 Elevation: _____

This part of the report must be completed by a licensed water well contractor or a licensed pump installer. A copy of Part 1 of the report must be attached and both parts filed with the Department at the above address within 30 days of well completion.

Well Owner Information	Well Location
Owner Name: <u>Charles L. Davis</u>	Latitude: _____ Longitude: _____
Mailing Address: <u>188 Leverette Lane</u>	Method of Lat/Long (check one): Conventional Survey _____
<u>Cascilla Ms. 38920</u>	USGS quad _____, Hand-held GPS <input checked="" type="checkbox"/> , Survey-grade GPS _____
City State Zip Code	<u>NW 1/4 SE 1/4 Sec 2 T 23N R 1E</u>
Telephone No. () _____	Distance Direction Nearest Town <u>2 Miles SE of Tippo</u>

Pump Type	Power Type
Circle one	Circle one
Air Lift Jet <input type="checkbox"/> <u>Submersible</u>	Diesel Engine Gasoline Engine Natural Gas
Bucket Piston Turbine	<u>Electric Motor</u> Hand Tractor PTO
Centrifugal Rotary Flowing Well	Windmill Other (specify): _____
Other (specify): _____	Horse Power Rating of Motor: <u>10</u>
Date Pump Installed: <u>11-9-10</u>	Setting Depth: <u>60</u> feet
Rated Pump Capacity: <u>550 ±</u> Gallons Per Minute	Number of Stages: <u>1</u>

Pump Test Data	Method of Measuring Water Level
Date Well Tested: _____	Circle one
Static Water Level (A): _____ Feet Below Land Surface	Air Line Electric Measuring Line Steel Tape
Pumping Water Level (B): _____ Feet Below Land Surface	Other (specify): _____
Drawdown [(B) - (A)]: _____ Feet Below Land Surface	For flowing well, measured shut in head: _____ feet
Test Pumping Rate: _____ Gallons Per Minute	Well yielded _____ GPM with a drawdown of _____ feet after _____ hours of pumping
Duration of Pump Test (minimum 4 hours): _____ hours	

This is for (circle one): New Well Replacement of Existing Pump Repair of Existing Pump

I HEREBY CERTIFY that the above statements are true to the best of my knowledge.
 Patrick M Chism 0695
 Print Name of Pump Installer and License No. (if applicable) Signature of Pump Installer

Form: OLWR-SWR-107-10

RECEIVED

NOV 23 2010

BY: OLWR