county: Tallahatchie	Part 1 – Drille	r's Log	for other est only.
Mine	issippi Department of E		Aquifer:
Permit #: 46937	Office of Land and Water Resources		Well #:
Driller: Joel Jumper	P.O. Box 2309 Jackson, MS 39225		
	(601)961- 5		L. S. Elevation:
Date drilling completed: 2-2-1-13	(601)961- 522	8 (fax)	E-log #:
Canada I anno anno anno alla della anno addita anno ad		aldan mannaible for s	
State Law requires that this report be partment at the above address within			
Information on Well Owner			orehole Location
(Landowner if borehole is not for a wa	ter well)	22 50 1/	90.00.01
Owner Name Brian Robe	rsno Latit	nge: <u>33 ° 30 ' 06</u>	_" Longitude: 90°08', 54'"
	I Meth	od of Lat/Long (circle or	ne): Conventional Survey,
Mailing Address: 204 North	Panola		
•		USGS quad Hand-held	GPS) Survey-grade GPS
	- NI	1/1/1/4 Sec 25	V Twn 23N Rng OLE
Charleston Ms	38921	2 /4 / V (X) /4 SCC (SC)	Twiles Twiles
City State	Zip Code Dista	nce Direction	Nearest Town of \(\frac{100}{100}\)
		Miles 5 1	of 11000
Telephone No. ()_	<del></del>		' '
	Well / Borehole D	eta	
2.7.2			26.
Date drilling started: 2-21-13 Date drilling of	ompleted: d-d-1-15F	ole depth: 120	Hole diameter: 2811
Location of the source of any surface water used	for drilling: \\ \langle \( \langle \)	+ 1,1011	]
Method of dosing and volume of Chlorine used i	n drilling and developmen	:	
Logs run (circle all applicable): No log run Elec	tric Gamma Ray Dens	ity Sonic Neutron	Other:
Name of organization running log(s):			
Purpose of borehole (check one): Water Well	Geotechnical/Geological 1	nvestigation Ground	Source Heat Pump
0			
Seismic Survey	Other (describe)	the remainder of this blo	not.
Purpose of Well (check one): Home Industria	l Public Supply Irr	igationFish Culture _	Other:
If a flowing well, method of flow regulation: Val-	ve Other (de	scribe)	
Static Water Level: A feet above of			2-27-17
	~	race Date measured:	4 4 17
Method of Measurement (circle one) steel tape	electric tape ai	r line other:	
Well depth: \( \sum \) Well grouted to a depth of	10 feet Type of grou	t (circle one): Neat Ceme	ent Bentonite Mix
Casing length: 60 feet Casing diam	eter: 10 inche	s Type of casing:	DUC
Screen length:feet	eter:inche	s Type of screen:	puc
	ing depth: From		120
Type of completion (circle all applicable): Graye			
-			
Otner	(describe):		
Top of lap pipe or reduction in casing:	feet. If telescoped	l or more than one scree	n, describe on next page


State Well Report

Form: OLWR-SWR-1A (04/08)
RECEIVED



The sketch	helaw	only	required	for	water	wells
I HE SACIEN	UCIUM	vmy	<i>rcumircu</i>	,v,	MARCI	Metta

### If well telescopes, show depths on sketch.

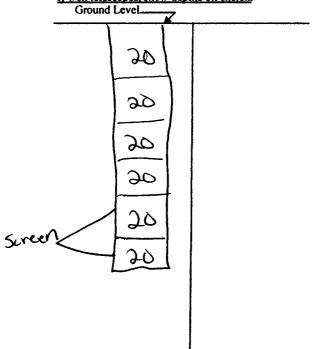

# Description of formations encountered must be provided for all wells and boreholes, unless specifically exempted by regulations

Description of Formations Encountered	From (depth)	To (depth)
Coumbo	Ground Level	20
Gumbo	30	40
Sand	40	CED
sand	(00)	80
Course sand	80	100
sand & grovel	/00	190
3		<b></b>
	ļ	<b> </b>
	<b></b>	
		<b> </b>
		<b> </b>
		<b></b>
	<del> </del>	<b></b>
<u> </u>		<b> </b>
	<del>                                     </del>	<del></del>
<u>                                     </u>		
		<b></b>
L	L., , , , , , , , , , , , , , , , , , ,	

If more than one screen, show location of each on sketch

Sketch the property layout and include the following: 1) the well location; 2) any permanent structures on the property that may aid in locating the well; 3) any roads, power lines, or other items that may aid in locating the property and the well; 4) a north arrow.
Youkapira High point R.
Tallahatchie Refuse
Landowner Name: Brian Roberson

Form: OLWR-SWR-1A (04/08)

I certify that the well/borehole was drilled, constructed, and completed in accordance with all applicable requirements of the Mississippi Department of Environmental Quality and the Mississippi Department of Health regulations, if applicable, and state

Joel Jumper 5317 2-27-13

Print Name of Responsible Licensee and License No.

Date

Signature of Licensee

MAR 2 5 2013



## STATE WELL REPORT

#### County: TALLAMATCHIE Permit #: <u>Gw - 46437</u> Driller: JOEL Jumper 2-27-13 Date completed: \_\_\_\_ Copy information from block on Part 1

### Part 2

Pump Installer's Completion Report
Mississippi Department of Environmental Quality
Office of Land and Water Resources P.O. Box 2309 Jackson, MS 39225-2309 (601)961-5210 (601) 360-0535 (fax)

For Office Use Only:
Well #: $\frac{\mathcal{S}}{\mathcal{S}}$
Aquifer:

This part of the report must be completed by a licensed water well contractor or a licensed pump installer. A copy of Part 1 of the report must be attached and both parts filed with the Department at the above address within 30 days of well completion.
Well Owner Information Well Location
Owner Name: BRIAN ROBERSON Latitude: 330 50, Obv. Longitude: 900 08, 544
Mailing Address:
CHARUESTON MS 3892/ USGS quad, Hand-held GPS, Survey-grade GPS
Situ NE 14 NN 14, Sec Z5 T Z3N R QE
State Zip Code 4.7
Telephone No. 662 458 - 6799 (Distance) (Direction) (Nearest Town)
Pump Type (circle one)
Submersible Turbine Air Lift Centrifugal Flowing Well Jet Piston Rotary Other (describe):
Date Pump Installed: 4-11-13 Rated Pump Capacity: 3000 Gallons Per Minute
Is This Pump (circle one): New Repaired Replacement
Power Type (circle one)
Electric Diesel Gasoline Natural Gas Tractor PTO Windmill Other (describe):
Horse Power Rating of Motor: 40 Setting Depth: 70 feet Number of Stages:/
Pump Test Data for Non Flowing Well  Date Well Tested: Duration of Pump Test (minimum 4 hours): hours
Static Water Level (A): Feet Below Land Surface Pumping Water Level (B): Feet Below Land Surface
Drawdown [(B) - (A)]: Feet Below Land Surface Test Pumping Rate: Gallons Per Minute
Method of measurement (circle one): Steel tape Electric tape Air line Other (describe):
Pump Test Data for Flowing Well
Measured shut in head:feet.
Well yieldedGPM with a drawdown offeet_afterhours of pumping
Meter Installation
Meter Manufacturer: Meter Serial Number:
Meter Model Number/Name: Type of Meter:
Totalizer Register Unit and Multiplier Factor (AF x .001, gal x 1000, etc):
nstallation Date: Meter installed by:
s This Meter (circle one): New Repaired Replacement
Important: By submitting the above information you are certifying that this meter was installed to manufacturer standards. For agricultural wells, a list of approved meters is on the MDEQ website.
HEREBY CERTIFY that the above statements are true to the best of my knowledge.
Dayon 2 1/2 - 0 22 2
rint Name of Pump Installer and License No. (if applicable)  Date  Signature of Pump Installer  Signature of Pump Installer
Form: OI WR-SWR-1B (4/13)