	STATE WELL REPORT	140
County: TALLAHATCHIE Permit #: EW- 50338 Driller: CHAD MATTOX Date drilling completed: 4/13/18	Part 1 Driller's Log Mississippi Department of Environmental Quality Office of Land and Water Resources P.O. Box 2309 Jackson, MS 39225-2309 (601)961-5210	For Office Use Only: well #: Aquifer: E-Log #:
	(601)360-0535 (fax)	

.

•

State Law requires that this report be prepared by the license holder responsible for the work and filed with the Department at the above address within 30 days of completion of drilling of the well or borehole.

Well Owner Information	Well or Borehole Location			
(Landowner if borehole is not for a water well)	Latitude: 335426 Longitude: 90 16 52			
Owner Name: Flautt FARMS	33-51-50     90-141-19       Method of Lat/Long (check one): Conventional Survey			
Mailing Address: PU BOX 237	1			
Maning AddressingKKS	USGS quad, Hand-held GPS, Survey-grade GPS			
11/200 29811	SW 1/4 SW 1/4, Sec 18 T 23NV R OIE			
WEBBMS32966CityStateZip Code	2.3 Miles N of SWAN LAKE			
Telephone No. (662) 375-2116	Z-3         Miles         IV         ot         Storp         Creation           (Distance)         (Direction)         (Nearest Town)         (Nearest Town)         (Nearest Town)			
Well / B	Borehole Data			
Date drilling started: 4/19/18 Date drilling completed	: <u><b>1</b>/13/18</u> Hole depth: <u>125</u> Hole diameter: <u>19</u> "			
Location of the source of any surface water used for drilli	ng: NEARBY DITCH			
4	and development:			
	ma Ray Density Sonic Neutron Other:			
Name of organization running log(s):				
Purpose of borehole (circle one): Water Well Geotechn	1			
Seismic Survey Other (describe)				
If drilling is not related to water well construction, skip the remainder of this block				
Purpose of Well (circle all applicable): Home Industrial	Public Supply Irrigation Fish Culture			
Other (describe):				
If a flowing well, method of flow regulation: Valve	Other (describe)			
Other (describe):				
Method of measurement (circle one): Steel tape Electric				
Well depth: 125' Well grouted to a depth of: 10 feet Type of grout (circle one): Neat Cement Bentonite Mix				
Casing length: <u>85</u> feet Casing diameter: <u>12</u> inches Type of casing: <u>PVC</u>				
Screen length: <u>40</u> feet Screen diameter:	12 inches Type of screen: PVC			
Screen slot size: .032inches Setting dept	h: From <u>60</u> feet to <u>90</u> feet			
Type of completion (circle all applicable): Gravel packed	Underreamed Open hole Natural Development			
Other (describe):				
Top of lap pipe or reduction in casing:feel	t			
If telescoped or more than	n one screen, describe on next page			


Form: OLWR-SWR-1A (4/13)

County: TALLAHATCHIE Permit #: 6W-50338

The sketch below only required for water wells

If well telescopes, show depths on sketch.

Ground Level

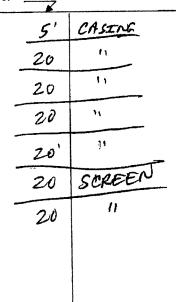

	For	Office	Use	Only:	
Wel	#:	Pa	19		

Description of formations encountered must be provided for all wells and boreholes, unless specifically exempted by regulations

Description of Formations Encountered	From (depth)	To (depth)
TOP SOIL	Ground level	12
FINE SAND	12	36
Course sand	36	42
Clay	42	
	59	64
Clay & course, sand Cubicse & med sand	64	81
MED SAND, PEA GRAVEL, J GRAVEL	81	125
GRAVEL	:	
		1
L	<u></u>	

If more than one screen, show location of each on sketch

Sketch the property layout and include the following: 1) the well location 2) any permanent structures on the property that may aid in locating the well
 3) any roads, power lines, or other items that may aid in locating the property and the well 4) north arrow

RECEIVED

SEP 21 201

Landowner Name:

I HEREBY CERTIFY that the well/borehole was drilled, constructed, and completed in accordance with all applicable requirements of the Mississippi Department of Environmental Quality and the Mississippi Department of Health regulations. if applicable, and state laws. 18

Date

onsible Licensee and License No.

Signature of Licensee Form: OLWR-SWR-1B (4/13)

CY OLM

	STATE W	ELL REPORT		
County: Talkhatchie	Part 2 Pump Installer's Completion Report Mississippi Department of Environmental Quality Office of Land and Water Resources		For Office Use Only:	
Permit #: <u>GW - 50338</u>			Well #: P99	
Driller: Chad mattex				
Date completed: 4/13/18		.O. Box 2309 n, MS 39225-2309	Aquifer:	
Copy information from block on Part 1		501)961-5210 ) 360-0535 (fax)		
Well Owner Information Dwner Name: Flauth Far Mailing Address: PO Box 23 Mailing Address: PO Box 23 Webb MS City State Telephone No. (Lole 2) 375-21 Submersible Turbine Air Lift Centrin Date Pump Installed: 4-18-18 Is This Pump (circle one): The Re	<u>ک</u> ک ک ک ک ک ک ک ک ک ک ک ک ک	Latitude: 33 54 26 Lon Method of Lat/Long (check one) USGS quad, Hand-held GF SW 1/4 Sec 2.3 Miles N (Direction) of (Direction) De (circle one) Jet Piston Rotary Other (de. Rated Pump Capacity: 850	scribe):	
Electric Diesel Gasoline Natural Gas	Tractor PTO Win	dmill Other (describe):	MAY 0 7 2018	
Electric Diesel Gasoline Natural Gas Horse Power Rating of Motor: 15	Tractor PTO Win	Idmill Other ( <i>describe</i> ): th:feet Number		
Horse Power Rating of Motor: 13 r	Tractor PTO Win P Setting Dept Pump Test Data	th:feet Number	of Stages:	
Date Well Tested:	Tractor PTO Win Pump Test Data	th:feet Number for Non Flowing Well Duration of Pump Test (minim	of Stages: <u>4.WR</u>	
Date Well Tested: Static Water Level (A): Fee	Tractor PTO Win Pump Test Data Pump Land Surface	In the second se	of Stages: WR um 4 hours): hour Feet Below Land Surface	
Date Well Tested: Static Water Level (A): Fee Drawdown [(B) - (A)]:	Tractor PTO Win Pump Test Data Below Land Surface Feet Below Land Surface	Admill Other ( <i>describe</i> ): th:feet Number for Non Flowing Well Duration of Pump Test ( <i>minim</i> Pumping Water Level (B): face Test Pumping Rate:	of Stages: MR um 4 hours): hour Feet Below Land Surface Gallons Per Minute	
Date Well Tested: Static Water Level (A): Fee Drawdown [(B) - (A)]:	Tractor PTO Win Pump Test Data Pump Test Data t Below Land Surface Feet Below Land Surface Leel tape Electric to	Admill Other ( <i>describe</i> ): th:feet Number for Non Flowing Well Duration of Pump Test ( <i>minim</i> Pumping Water Level (B): face Test Pumping Rate:	of Stages: MR um 4 hours): hour Feet Below Land Surface Gallons Per Minute	
Horse Power Rating of Motor: <u>13</u> Date Well Tested: Static Water Level (A): <u>3</u> Fee Drawdown [(B) - (A)]: Method of measurement ( <i>circle one</i> ): S	Tractor PTO Win Pump Test Data Pump Test Data t Below Land Surface Feet Below Land Surface Leel tape Electric t Pump Test Da	Indmill Other ( <i>describe</i> ): th:feet Number for Non Flowing Well Duration of Pump Test ( <i>minim</i> Pumping Water Level (B): face Test Pumping Rate: ape Air line Other ( <i>describe</i> ):	of Stages: MR um 4 hours): hour Feet Below Land Surface Gallons Per Minute	
Torse Power Rating of Motor: <u>2</u> Date Well Tested: Static Water Level (A): <b>3</b> و Drawdown [(B) - (A)]: Method of measurement ( <i>circle one</i> ): S	Tractor PTO Win Pump Test Data Pump Test Data t Below Land Surface Feet Below Land Surface Feet Below Land Surface Leel tape Electric to Pump Test Data t.	Admill Other ( <i>describe</i> ): th:feet Number for Non Flowing Well Duration of Pump Test ( <i>minim</i> Pumping Water Level (B): face Test Pumping Rate: ape Air line Other ( <i>describe</i> ): ta for Flowing Well	of Stages:hour um 4 hours):hour Feet Below Land Surface Gallons Per Minut	
Horse Power Rating of Motor: <u>2</u> Date Well Tested: Static Water Level (A): <b>3</b> و Drawdown [(B) - (A)]: Method of measurement ( <i>circle one</i> ): S	Tractor PTO Win Pump Test Data Pump Test Data Test Below Land Surface Feet Below Land Surface Feet Below Land Surface Leel tape Electric to Pump Test Data t. drawdown of	Admill Other ( <i>describe</i> ): feet Number for Non Flowing Well Duration of Pump Test ( <i>minim</i> Pumping Water Level (B): face Test Pumping Rate: ape Air line Other ( <i>describe</i> ): _ ta for Flowing Well feet after	of Stages:hour um 4 hours):hour Feet Below Land Surface Gallons Per Minut	
Horse Power Rating of Motor: <u>13</u> Date Well Tested: Static Water Level (A): <u>36</u> Fee Drawdown [(B) - (A)]: Fee Method of measurement ( <i>circle one</i> ): S Measured shut in head:fee Well yieldedGPM with a	Tractor PTO Win Pump Test Data Pump Test Data t Below Land Surface Feet Below Land Surface Leel tape Electric t Pump Test Da t. drawdown of Meter	Admill Other ( <i>describe</i> ): th:feet Number for Non Flowing Well Duration of Pump Test ( <i>minim</i> Pumping Water Level (B): face Test Pumping Rate: face Test Pumping Rate: ta for Flowing Well feet after Installation	of Stages: hour um 4 hours): hour Feet Below Land Surface Gallons Per Minut hours of pumping	
Horse Power Rating of Motor: <u>19</u> Date Well Tested: Static Water Level (A): <u>36</u> Fee Drawdown [(B) - (A)]: Fee Method of measurement ( <i>circle one</i> ): S Measured shut in head:fee Well yielded GPM with a	Tractor PTO Win Pump Test Data Pump Test Data Pump Test Data t Below Land Surface Feet Below Land Surface Feet Below Land Surface Leel tape Electric t Pump Test Data t. drawdown of Meter	Admill Other ( <i>describe</i> ): th:feet Number for Non Flowing Well Duration of Pump Test ( <i>minim</i> Pumping Water Level (B): face Test Pumping Rate: face Test Pumping Rate: ta for Flowing Well feet after Installation Meter Serial Number:	of Stages:hour num 4 hours):hour Feet Below Land Surface Gallons Per Minut hours of pumping	
Horse Power Rating of Motor:   Date Well Tested:   Date Well Tested:   Static Water Level (A):   Joan   Fee   Drawdown [(B) - (A)]:   Method of measurement (circle one):   Measured shut in head:   GPM with a   Meter Manufacturer: Meter Model Number/Name:	Tractor PTO Win Pump Test Data Pump Test Data t Below Land Surface Feet Below Land Sur teel tape Electric to Pump Test Data t. drawdown of Meter	Admill Other ( <i>describe</i> ):	of Stages:hour um 4 hours):hour Feet Below Land Surface Gallons Per Minut hours of pumping	
Horse Power Rating of Motor:       13         Date Well Tested:	Tractor PTO Win Pump Test Data Pump Test Data t Below Land Surface Feet Below Land Surface Feet Below Land Surface Leet tape Electric to Pump Test Data t. drawdown of Meter Factor (AF x .001, gata)	Image: Admilletion of Pump Test (minime         for Non Flowing Well         Duration of Pump Test (minime         Pumping Water Level (B):         face         Test Pumping Rate:         ape         Air line         Other (describe):         ta for Flowing Well        feet         Installation        Type of Meter:        Type of Meter:         I x 1000, etc):	of Stages: hour um 4 hours): hour Feet Below Land Surface Gallons Per Minut hours of pumping	
Horse Power Rating of Motor:       13 min.         Date Well Tested:	Tractor PTO Win Pump Test Data Pump Test Data Et Below Land Surface Feet Below Land Surface Teel tape Electric t Pump Test Data t. drawdown of Factor (AF x .001, ga Meter installed by:	indmill Other (describe):	of Stages:hour um 4 hours):hour Feet Below Land Surface Gallons Per Minute hours of pumping	
Horse Power Rating of Motor:       12         Date Well Tested:	Tractor PTO Win Pump Test Data Pump Test Data Test Below Land Surface Feet Below Land Surface Feet Below Land Sur teel tape Electric to Pump Test Data t. drawdown of Meter Factor (AF x .001, ga Meter installed by: Epaired Replacem	Admill Other ( <i>describe</i> ): th:	of Stages:hour um 4 hours):hour Feet Below Land Surface Gallons Per Minute hours of pumping	
	Tractor PTO Win Pump Test Data Pump Test Data Test Below Land Surface Feet Below Land Surface Feet Below Land Sur teel tape Electric to Pump Test Data t. drawdown of Meter Factor (AF x .001, ga Meter installed by: Epaired Replacem	Admill Other ( <i>describe</i> ): th:	of Stages:hour um 4 hours):hour Feet Below Land Surface Gallons Per Minute hours of pumping	

<b>F</b>	OLUVE CWE 1P	11/17
Form:	OLWR-SWR-1B	(4/15)